

SECTION CORNER RECORD

BOONE COUNTY SURVEYOR'S OFFICE

NE 100-100

State Plane grid coordinates NAD83 (CORS96):

North: 1750906.16 East: 3129844.97 (U.S. survey feet)

Type of monument: Harrison, 4" disk 'Section Corner'

Depth: One inch below adjacent road surface

Indiana tie card references:

IN02_T19NR1E30_80 IN02_T19NR1E29_72

IN02_T19NR1E31_08 IN02_T19NR1E32_00



CORNER WITNESS DETAIL

SCALE 1" = 40'

- A - Boone County witness mark, flush, 28.54'
- B - Mag nail found in W. side, wood corner post, 3 in. a.g., 34.65'
- C - Mag nail found in N. side power pole, 4 in. a.g., 15.20'
- D - Mag spike found in E. side power pole, 14 in. a.g., 12.10'

Boone County witness mark is a 3/8" diameter x 2' long rebar bearing a metal cap stamped "Boone County Witness Point."



The harrison monument was found in place.

No specific descriptions of this corner were found in the BCS Surveyor's Record. An undated tie card believed to date from the late 1960s (most likely from 1968) shows the corner as a stone found, R.R. rail set, with attribution to the crew of "Ken and J.R." A tie card dated August 2, 2005 shows the corner as a harrison monument with no documentation of source.

It is known that it was common practice for crews in the late 1960s and early 1970s to remove a corner stone, if found, and replace it with a railroad rail set vertically. The 2005 tie card does not document the monument found or replaced when the harrison monument was set, but the distance ties generally agree with the ties from the earlier tie card.

No excavation was performed at this corner. The harrison monument appears to be stable and is believed to be in the same position as the stone found previously. The harrison monument was held as marking the corner.

This corner was originally established as a wood post in June, 1822.

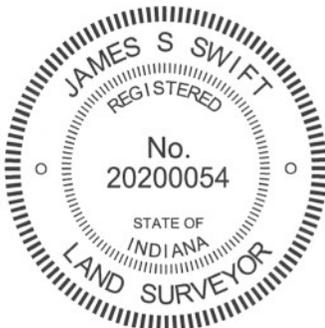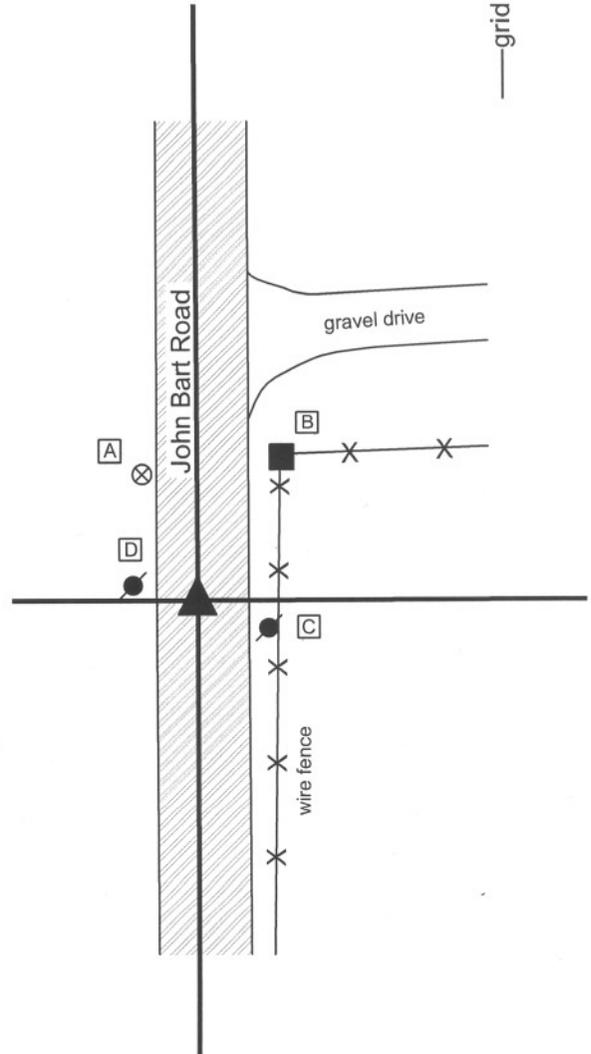

Kenneth E. Hedge
 Kenneth E. Hedge, County Surveyor

James S. Swift
 James S. Swift, IN LS 20200054
 January 15, 2013

Center Township

| | |
|-------------------------|-------------------------|
| Section 30 T19N, R1E | Section 29 T19N, R1E |
| Section 31 T19N, R1E | Section 32 T19N, R1E |

SECTION CORNER RECORD

BOONE COUNTY SURVEYOR'S OFFICE

NE 150-100

State Plane grid coordinates NAD83 (CORS96):
 North: 1753540.24 East: 3129831.70 (U.S. survey feet)

Type of monument: Harrison, 4" disk 'Section Corner'
 Depth: One inch below adjacent road surface

Indiana tie card references:
 IN02_T19NR1E29_36
 IN02_T19NR1E30_44



CORNER WITNESS DETAIL

SCALE 1" = 40'

- A - Mag nail set in N.E. side power pole, 1' a.g., 20.57'
- B - Boone County witness mark, flush, 30.20'
- C - Mag nail set in W. side power pole, 1' a.g., 73.10'
- D - Boone County witness mark, flush, 40.74'

Boone County witness mark is a 3/8" diameter x 2' long rebar bearing a metal cap stamped "Boone County Witness Point."


The harrison monument was set in place of a harrison monument found. A BCS record dated October 1, 1870 states "Reestablished from stumps. Rock 25.12.1." A BCS tie card dated August 2, 2005 shows the corner as a harrison monument with no documentation of source. This corner was excavated on June 26, 2012. Prior to excavation, a harrison monument was found at 2 inches below grade, in conformity with the 2005 distance ties. Excavation revealed a railroad rail found at 14 inches deep, directly below the harrison monument. Excavation of a 5 foot N-S by 5 foot E-W area centered on the harrison revealed no further evidence of the corner. Excavation was performed to a depth of 30 inches. The bottom of the road bed was found at approximately 26 inches deep. A new harrison monument was set in place of the found monument. This corner was originally established as a wood post in June, 1822.

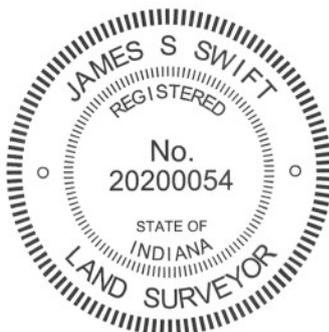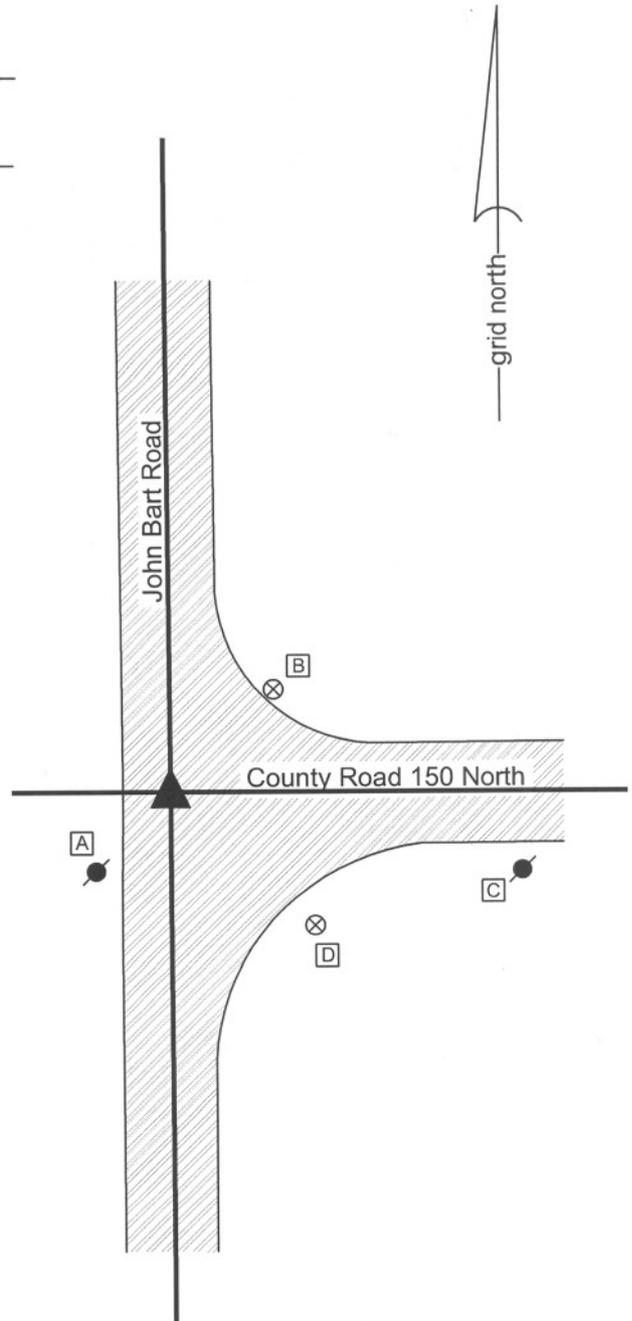

Kenneth E. Hedge
 Kenneth E. Hedge, County Surveyor

James S. Swift
 James S. Swift, IN LS 20200054
 January 15, 2013

Center Township

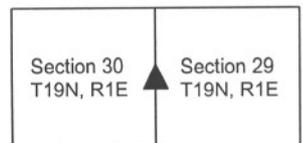

SECTION CORNER RECORD

BOONE COUNTY SURVEYOR'S OFFICE

NE 200-100

State Plane grid coordinates NAD83 (CORS96):

North: 1756190.19 East: 3129814.17 (U.S. survey feet)

Type of monument: Harrison, 4" disk 'Section Corner'

Depth: One inch below adjacent road surface

Indiana tie card references:

IN02_T19NR1E19_80 IN02_T19NR1E20_72

IN02_T19NR1E30_08 IN02_T19NR1E29_00

CORNER WITNESS DETAIL

SCALE 1" = 40'



- A - Boone County witness mark, flush, 25.63'
- B - Mag nail found in S. side power pole, 3 in. a.g., 14.47'
- C - Boone County witness mark, flush, 38.88'
- D - Mag nail found in W. side power pole, 1' a.g., 16.59'

Boone County witness mark is a 3/8" diameter x 2' long rebar bearing a metal cap stamped "Boone County Witness Point."

The harrison monument was set in place of a harrison monument found. No specific descriptions of this corner were found in the BCS Surveyor's Record. A BCS tie card dated January 30, 1968 states "no stone found." A BCS tie card dated August 2, 2005 shows the corner as a harrison monument with no documentation of source.

This corner was excavated on June 26, 2012. Prior to excavation, a harrison monument was found at 2 inches below grade. Excavation revealed a vertical section of railroad rail found at 11 inches deep. The harrison monument had been 2 inches west of the position of the top of the rail. Excavation of an area extending 2.5 feet N, 2.5 feet S, 3 feet E and 2 feet W of the harrison/rail revealed no further evidence of the corner. Excavation was performed to a minimum of 17 inches, at least 3 inches into the clay layer found below the road bed. The top of the rail, as found, was held as marking the corner. The rail was removed during excavation and was replaced with a harrison monument in the same position.

This corner was originally established as a wood post in June, 1822.

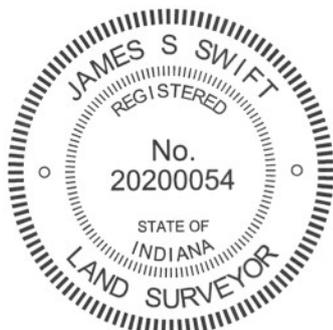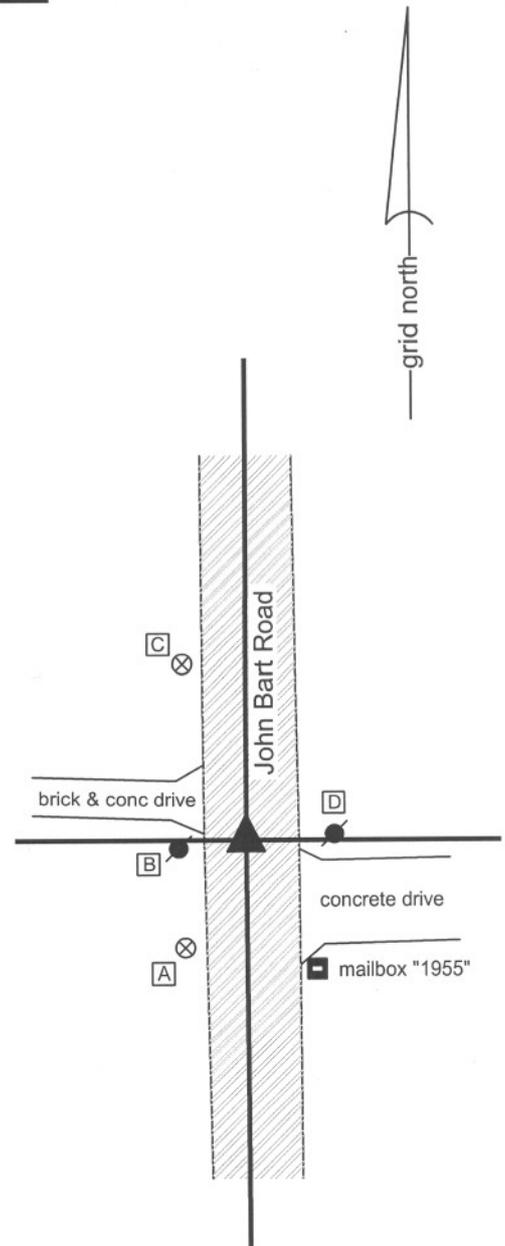

Kenneth E. Hedge
 Kenneth E. Hedge, County Surveyor

James S. Swift
 James S. Swift, IN LS 20200054
 January 15, 2013

Center Township

| | |
|-------------------------|-------------------------|
| Section 19 T19N, R1E | Section 20 T19N, R1E |
| Section 30 T19N, R1E | Section 29 T19N, R1E |