

SECTION CORNER RECORD

SE 050-1100

BOONE COUNTY SURVEYOR'S OFFICE

State Plane grid coordinates NAD83 (NSRS 2007):

North: 1744417.89 East: 3183267.93 (U.S. survey feet)

Type of monument: Harrison, 4" disk 'Section Corner'

Depth: One inch below adjacent road surface

Indiana tie card references:


IN02_T18NR2E01_36

IN02_T18NR2E02_44



CORNER WITNESS DETAIL

SCALE 1" = 30'

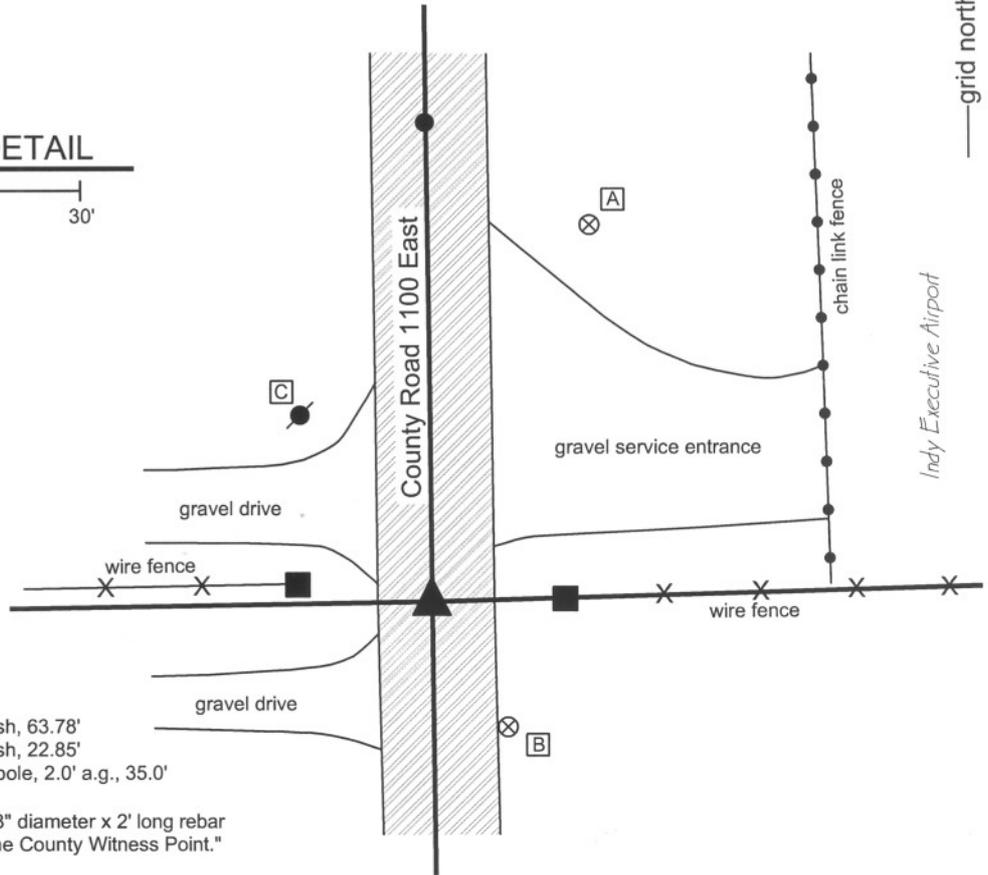

- A - Boone County witness mark, flush, 63.78'
- B - Boone County witness mark, flush, 22.85'
- C - Mag nail set in S.E. side power pole, 2.0' a.g., 35.0'

Boone County witness mark is a 3/8" diameter x 2' long rebar bearing a metal cap stamped "Boone County Witness Point."

The harrison monument was set in place of a bolt spike over a stone found.

A BCS tie card dated May 30, 1991 shows the corner as a bolt spike. This tie card also shows a rebar 3.2 feet north of the spike. No specific records of the corner were found in the BCS Surveyor's Record, though the corner is depicted as the terminal point for measurements in 1834, 1837 and 1897.

This corner was excavated on May 14, 2009. Prior to excavation the bolt spike and the rebar shown on the 1991 tie card were visible. The bolt spike was 2 inches below the adjacent pavement and the rebar was flush with the pavement. A stone was found at 11 inches deep measuring 6 inches E-W by 5 inches N-S with the top 6 inches of the stone exposed. The stone is well embedded in the clay layer below the road and protrudes approximately 4 inches out of the clay into the base layer of the road. With 6 inches exposed the stone remained entirely stable in the clay. The stone was left in place and the total height was not measured. An etched "+" is visible on the top of the stone. Prior to exposing the stone the bolt spike had been removed but it was apparent that the bolt spike had been driven along the west edge of the stone at an angle and leaning over the top of the stone. The harrison monument was set in the position of the bolt spike, over the west side of the top of the stone, 0.15 foot west of the etched "+" on top of the stone.

This corner was originally established as a wood post in July, 1821.



Kenneth E. Hedge
Kenneth E. Hedge, County Surveyor

James S. Swift
James S. Swift, IN LS 20200054
July 14, 2010

Union Township

Section 2 T18N, R2E	Section 1 T18N, R2E
------------------------	------------------------

PHOTOGRAPHIC DOCUMENTATION

Date of photography: May 14, 2009

View of the stone as first exposed.



View of the stone from above, wetted, showing the etched + on the top of the stone.



View from the north, looking across the stone and south along County Road 1100 East.



View from the west, looking across the stone and east along the old fence.



For details and documentation, refer to related sheet "Section Corner Record."

SECTION CORNER RECORD

SE 100-1100

BOONE COUNTY SURVEYOR'S OFFICE

State Plane grid coordinates NAD83 (NSRS 2007):

North: 1741780.88 East: 3183299.48 (U.S. survey feet)

Type of monument: Harrison, 4" disk 'Section Corner'

Depth: One inch below adjacent road surface



Indiana tie card references:

IN02_T18NR2E01_72 IN02_T18NR2E02_80

IN02_T18NR2E11_08 IN02_T18NR2E12_00

CORNER WITNESS DETAIL

SCALE 1" = 30'

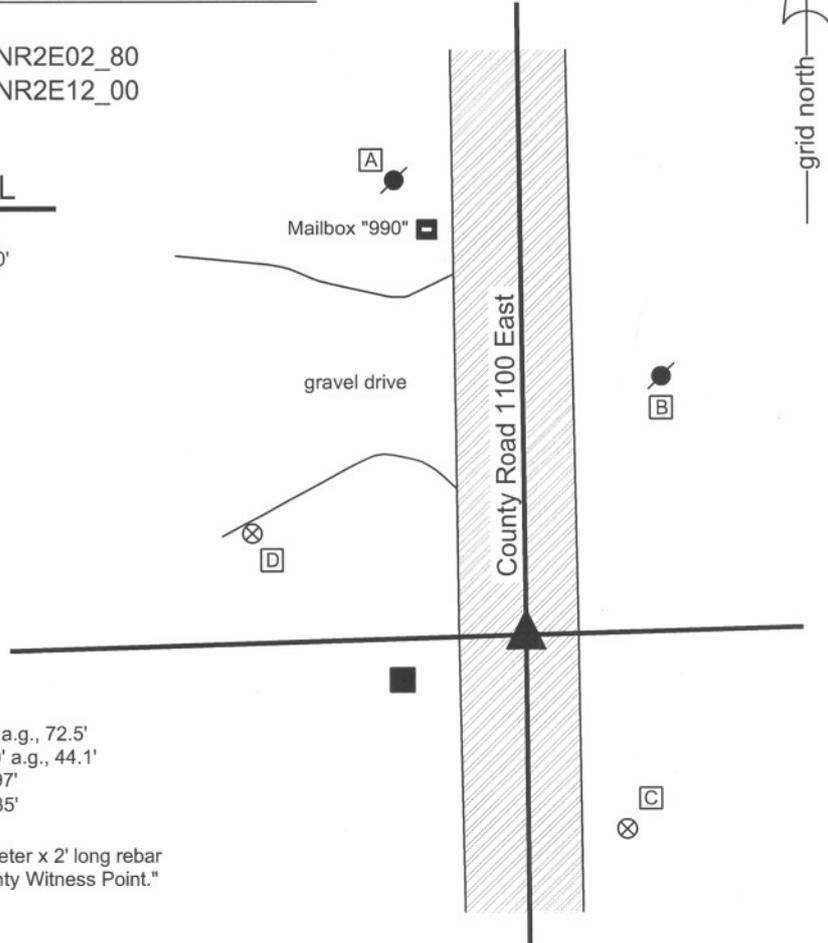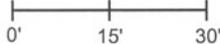


- A - Mag nail set in SE side power pole, 2.0 a.g., 72.5'
- B - Mag nail set in SW side power pole, 2.0' a.g., 44.1'
- C - Boone County witness mark, flush, 33.97'
- D - Boone County witness mark, flush, 45.35'

Boone County witness mark is a 3/8" diameter x 2' long rebar bearing a metal cap stamped "Boone County Witness Point."

The harrison monument was set over a stone found.

A BCS record of August 25, 1871 states "Reestablished Set a Rock 20.12 by 9 +." A BCS tie card dated May 31, 1991 shows the corner as a 5/8 inch rebar found. This corner was excavated on May 1, 2009. Prior to excavation a 5/8 inch rebar with a red plastic cap was found flush with the surface, in agreement with the 1991 distance ties. Excavation revealed the record stone found at 16 inches deep south and east of the rebar. With 13 inches of the stone exposed, the stone measures 12 inches E-W by 9 inches N-S. The etched "+" is clearly visible on the top of the stone. The stone is completely embedded in the clay layer below the road bed, with the top of the stone approximately at the top of the clay layer. The stone is split horizontally at 6 inches from the top. After measuring and documenting the stone, the top portion was reset on the bottom portion and packed back together with the surrounding clay. The entire stone was left in place. The harrison monument was set directly over the etched "+" on the stone, which point is 1.1 feet south and 3.5 feet east of the rebar (removed during excavation.)

This corner was originally established as a wood post in July, 1821.

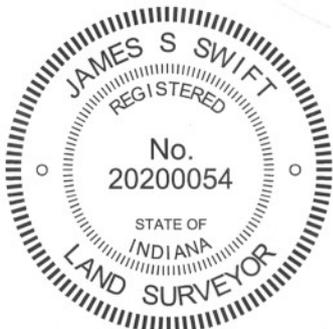

Kenneth E. Hedge

 Kenneth E. Hedge, County Surveyor

James S. Swift

 James S. Swift, IN LS 20200054
 July 14, 2010, Revised April 30, 2012

Union Township

Section 2 T18N, R2E	Section 1 T18N, R2E
Section 11 T18N, R2E	Section 12 T18N, R2E

PHOTOGRAPHIC DOCUMENTATION

Date of photography: May 1, 2009

View of the stone as first exposed.



View of the stone more fully exposed.
View from above and south.



View from over the stone, looking north along
County Road 1100 East.



Similar view to above with the etched mark
on the top of the stone brushed clean.



View of the stone from above and west.



For details and documentation, refer to
related sheet "Section Corner Record."