

SECTION CORNER RECORD

BOONE COUNTY SURVEYOR'S OFFICE

NE 700-450

State Plane grid coordinates NAD83 (CORS96):

North: 1782886.26 East: 3148007.82 (U.S. survey feet)

Type of monument: Harrison, 4" disk 'Section Corner'

Depth: Six inches below adjacent gravel road surface

Indiana tie card references:

IN02_T20NR1E26_76


IN02_T20NR1E35_04

CORNER WITNESS DETAIL

SCALE 1" = 30'

- A - Mag nail set in E. side, wood post, 2' a.g., 19.9'
- B - Boone County witness mark, flush, 23.0'
- C - Mag nail set in N. side, power pole, 2' a.g., 32.6'

Boone County witness mark is a 3/8" diameter x 2' long rebar bearing a metal cap stamped "Boone County Witness Point."

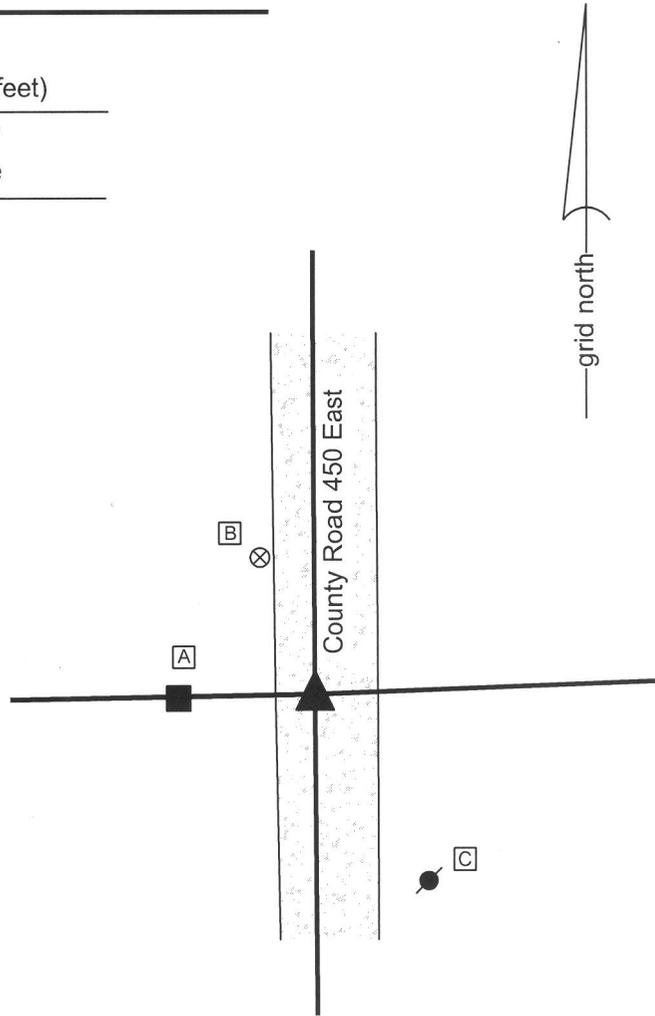


The harrison monument was set over a stone found.

A BCS record of March 12, 1874 states "Reestablished from the roots of both trees. Set Rock 24.13.13 +." A BCS tie card dated June 3, 1975 states "No stone found - set rod."

This corner was excavated on December 3, 2013. Prior to excavation a 1/2 inch diameter rebar was found disturbed at the surface of the gravel road, approximately 3 feet west of the center of the roadway. Excavation revealed a stone found at 14 inches deep. The top 12 inches of the stone were exposed, at which point the stone measured 13 inches N-S by 11 inches E-W, with the appearance that the stone was yet larger in the E-W dimension towards the base. The stone was embedded in the clay layer below the road, protruding approximately 3 inches into the bottom of the road bed. The stone had a distinct and clearly visible etched "+" mark on the top, sloping north side of the stone. The highest point of the stone was approximately 2 inches south of the mark, but it was not clear whether the stone was undisturbed or had possibly been leaned slightly to the north. The mark appeared to be generally over the center of the mass of the stone. The stone was accepted as being the monument described in the 1874 record. The stone was left in place and a harrison monument was set over the etched "+" mark on the top of the stone. The rebar, removed during excavation, had been 1.5' west of the stone.


This corner was originally established as a wood post in 1822.

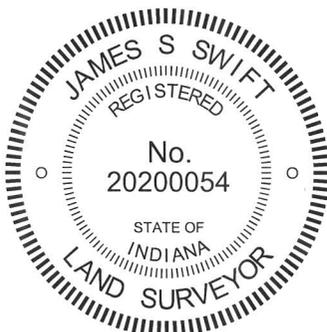

Kenneth E. Hedge
 Kenneth E. Hedge, County Surveyor

James S. Swift
 James S. Swift, IN LS 20200054
 February 5, 2015

Clinton Township

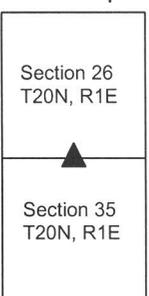

PHOTOGRAPHIC DOCUMENTATION
Date of photography: December 3, 2013

View of the stone as first exposed.



View of the stone from the west,
looking east along the adjacent fence.



View of the stone from above and south.



View of the stone from directly above.



For details and documentation, refer to
related sheet "Section Corner Record."