

SECTION CORNER RECORD

BOONE COUNTY SURVEYOR'S OFFICE

NE 200-100

State Plane grid coordinates NAD83 (CORS96):

North: 1756190.19 East: 3129814.17 (U.S. survey feet)

Type of monument: Harrison, 4" disk 'Section Corner'

Depth: One inch below adjacent road surface

Indiana tie card references:

IN02_T19NR1E19_80 IN02_T19NR1E20_72

IN02_T19NR1E30_08 IN02_T19NR1E29_00

CORNER WITNESS DETAIL

SCALE 1" = 40'



- A - Boone County witness mark, flush, 25.63'
- B - Mag nail found in S. side power pole, 3 in. a.g., 14.47'
- C - Boone County witness mark, flush, 38.88'
- D - Mag nail found in W. side power pole, 1' a.g., 16.59'

Boone County witness mark is a 3/8" diameter x 2' long rebar bearing a metal cap stamped "Boone County Witness Point."

The harrison monument was set in place of a harrison monument found. No specific descriptions of this corner were found in the BCS Surveyor's Record. A BCS tie card dated January 30, 1968 states "no stone found." A BCS tie card dated August 2, 2005 shows the corner as a harrison monument with no documentation of source.

This corner was excavated on June 26, 2012. Prior to excavation, a harrison monument was found at 2 inches below grade. Excavation revealed a vertical section of railroad rail found at 11 inches deep. The harrison monument had been 2 inches west of the position of the top of the rail. Excavation of an area extending 2.5 feet N, 2.5 feet S, 3 feet E and 2 feet W of the harrison/rail revealed no further evidence of the corner. Excavation was performed to a minimum of 17 inches, at least 3 inches into the clay layer found below the road bed. The top of the rail, as found, was held as marking the corner. The rail was removed during excavation and was replaced with a harrison monument in the same position.

This corner was originally established as a wood post in June, 1822.

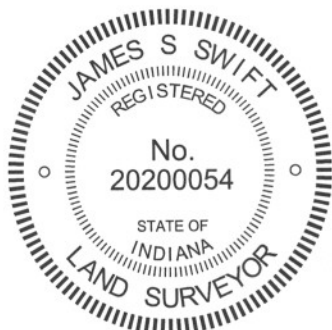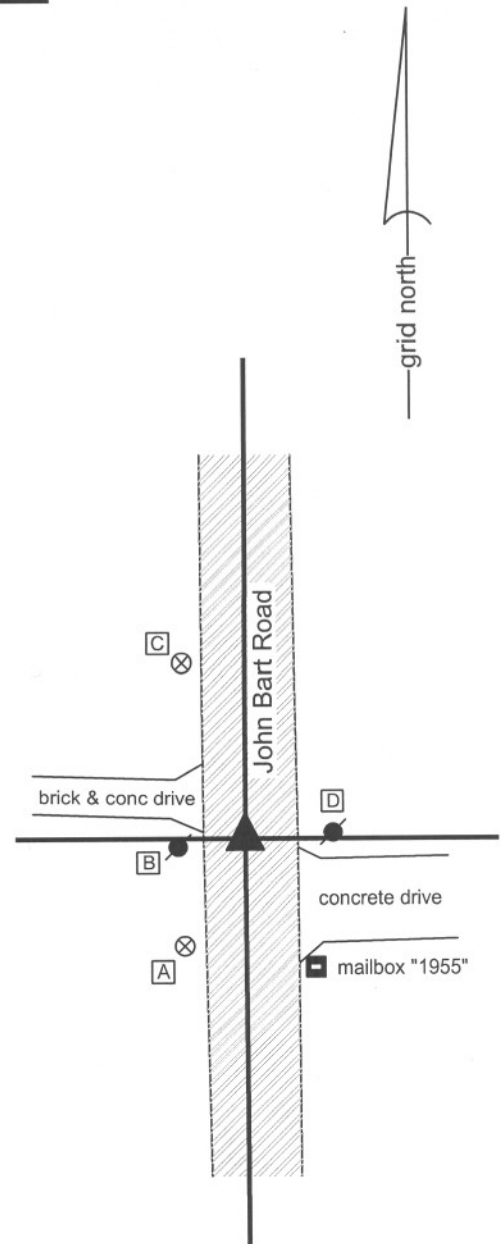

Kenneth E. Hedge
 Kenneth E. Hedge, County Surveyor

James S. Swift
 James S. Swift, IN LS 20200054
 January 15, 2013

Center Township

Section 19 T19N, R1E	Section 20 T19N, R1E
Section 30 T19N, R1E	Section 29 T19N, R1E