

SECTION CORNER RECORD

NE 450-100

BOONE COUNTY SURVEYOR'S OFFICE

State Plane grid coordinates NAD83 (CORS96):

North: 1769421.18 East: 3129833.31 (U.S. survey feet)

Type of monument: Harrison, 4" disk 'Section Corner'

Depth: six inches below adjacent gravel road surface

Indiana tie card references:



IN02_T19NR1E07_44

IN02_T19NR1E08_36



CORNER WITNESS DETAIL


SCALE 1" = 30'

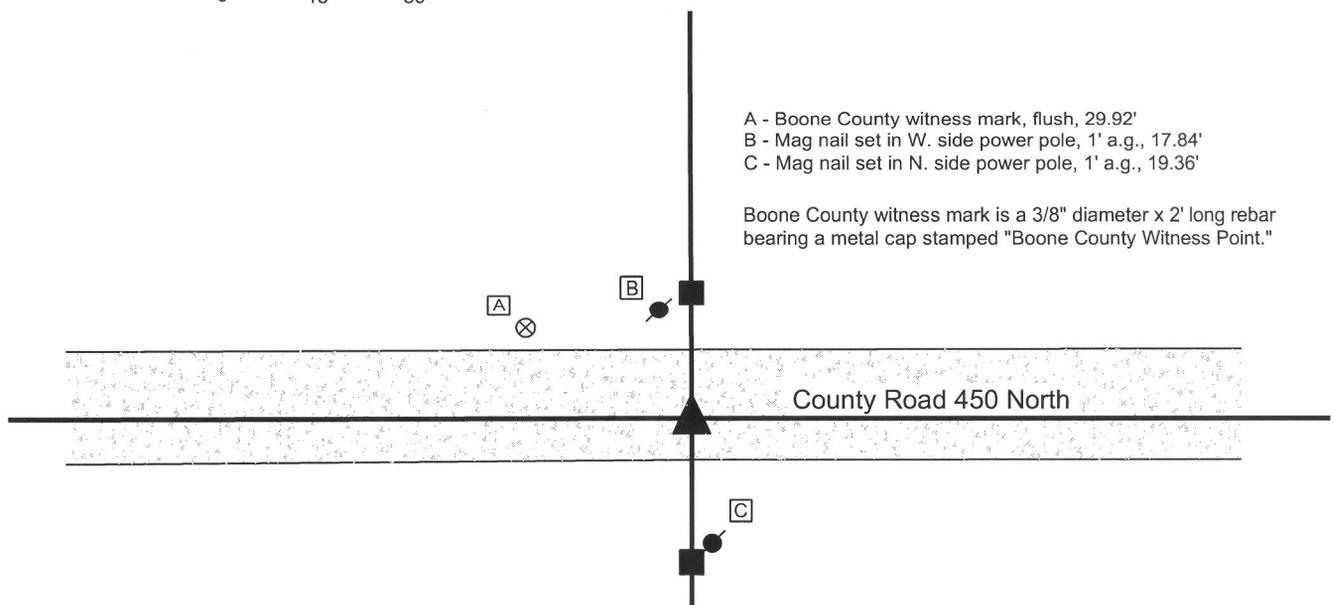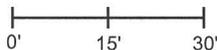

The harrison monumet was set in place of a vertical section of railroad rail found.

A BCS record of February 28, 1872 states "Reestablished from stump of Ash drove stake and put a Rock 12.7.6 +..." A BCS tie card dated July, 1968 states "No stone." A BCS tie card dated August 28, 2005 shows the corner as a railroad rail with no documentation of source.


This corner was excavated on June 18, 2012. Prior to excavation a railroad rail was found at 1 inch deep, slightly south of center of the county road. Excavation of an area extending 2 feet south, 6 feet north, 5 feet east and 5 feet west of the rail revealed no further evidence of the corner. It is noted that the road bed in this area is of minimal thickness, being only approximately 6 inches. The stone described in the 1872 record was not large. Given the minimal depth of the road and the small size of the stone, it is reasonable to conclude that the stone may have been removed by road grading equipment. The rail fit generally with local evidence, being in the east-west road and in line with the posts to the north and south. The rail was 19.5 feet south of old post on the north side of the road, approximately 2 feet south of the center of the gravel road. Excavation was performed in area far enough north to center the area of excavation on a position approximately 1 rod (16.5 feet) south of the old post. As no other evidence was found, the rail was held as marking the corner. The rail was removed during excavation and replaced with a harrison monument in the same position. This corner was originally established as a wood post in June, 1822.

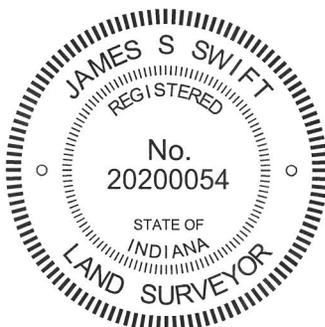

Kenneth E. Hedge, County Surveyor

James S. Swift, IN LS 20200054
February 6, 2013

Clinton Township

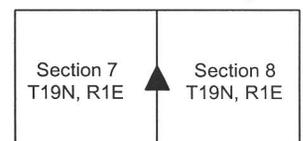

SECTION CORNER RECORD

BOONE COUNTY SURVEYOR'S OFFICE

NE 500-000

State Plane grid coordinates NAD83 (CORS96):

Corner 1: North: 1772009.54 East: 3124823.06 (U.S. survey feet)

Corner 2: North: 1772102.14 East: 3124822.80 (U.S. survey feet)

Type of monument: Harrison, 4" disk 'Section Corner'

Depth: flush to 2 inches above adjacent ground.


Indiana tie card references:

IN02_T19NR1E06_72 IN02_T19NR1E07_00

IN02_T19NR1W01_80 IN02_T19NR1W12_08

- A - Nail in S. edge wood end post, 1' a.g., 103.93' to corner 1, 11.33' to corner 2
- B - Boone County witness mark, flush, 92.68' to corner 1, 29.56' to corner 2
- C - Mag nail set in W. side power pole, 1' a.g., 13.95' to corner 1, 78.98' to corner 2
- D - Boone County witness mark, flush, 33.54' to corner 1, 102.24' to corner 2

Boone County witness mark is a 3/8" diameter x 2' long rebar bearing a metal cap stamped "Boone County Witness Point."

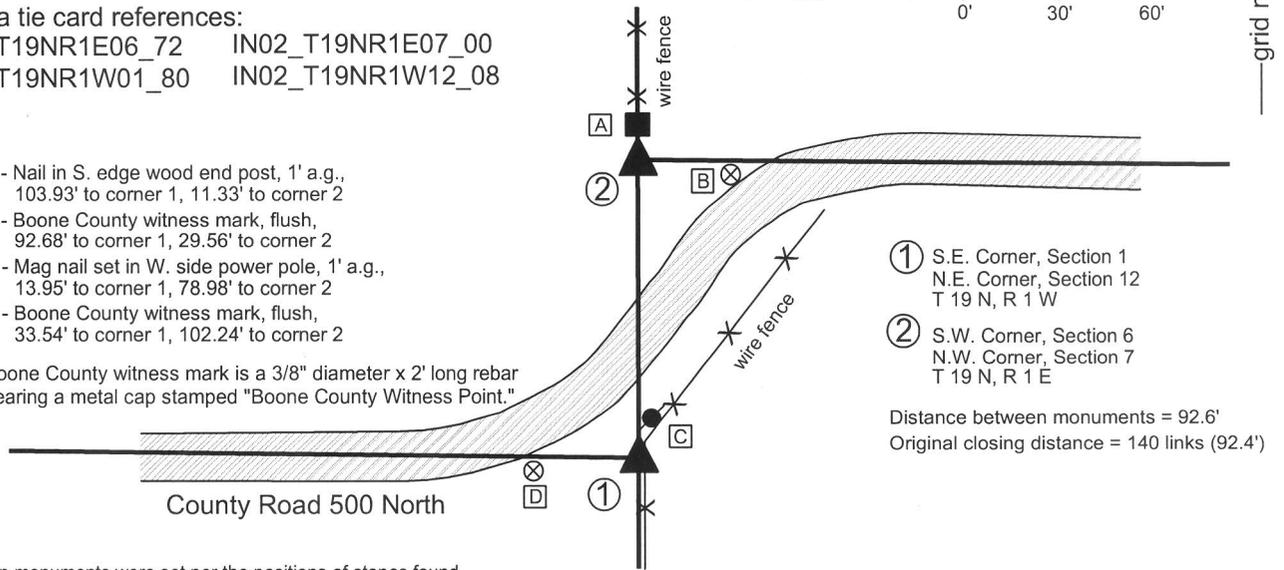

- ① S.E. Corner, Section 1
N.E. Corner, Section 12
T 19 N, R 1 W
- ② S.W. Corner, Section 6
N.W. Corner, Section 7
T 19 N, R 1 E

Distance between monuments = 92.6'
Original closing distance = 140 links (92.4')

The Harrison monuments were set per the positions of stones found.


A BCS record of May 9, 1872 pertaining to the southwest corner of section 6, T19N, R1E (corner 2) states "Reestablished from Elm and Stump of Burr Oak. Elm is 67 links dist. Set Rock 14.8.5 1/2 marked +." A BCS record of April 19, 1895 pertaining to the southeast corner of section 1, T19N, R1W (corner 1) states "Set rock 24x15x5 established from lap." It is noted that the term "lap" refers to the offset distance between the standard and closing corners on the range line. At this corner the "lap" recorded in the original notes is 140 links, or 92.4 feet.

BCS tie cards dated October 14, 1971 pertaining to each of the corners state that a stone was found at corner 1 and that no stone was found and a RRR (railroad rail) was "put in" at corner 2. The tie cards show the two corners to be 97 feet apart. A BCS tie card dated January 18, 1994 pertaining to corner 1 shows the corner as being a 1/2 inch rebar. This card shows corner 1 to be 108 feet south of a corner post to the north. As the rail called for in the 1971 tie card was found at 11 feet south of this post and the stone called for in 1971 tie card was shown to be 97 feet south of the rail, it is evident that the 1/2 inch rebar called for in 1994 was in the position of the stone called for in 1971. A pair of BCS tie cards dated September 20, 2005 show corner 1 as a Harrison monument and corner 2 as a railroad rail, with the two monuments at 92.39 feet apart.

Excavation in the fall of 2013, concluding on October 29, 2013 revealed both of the record stones described in the 1872 and 1895 records. The stone at corner 1 was found at 4 inches deep, slightly southwest of the Harrison monument shown on the 2005 record. This stone measures 24 inches tall by 15 inches N-S by 5 inches E-W. The rebar shown on the 1994 tie card was found 4.6 feet south and 1.4 feet west of the stone. The stone at corner 2 was found 0.8 feet south and 0.8 feet east of the railroad rail shown on the 1971 and 2005 tie cards. This stone was found at 6 inches deep and measured 14 inches tall by 8 inches E-W by 5 1/2 inches N-S. The distance measured from the high point to the high point of the respective stones was 92.6 feet, barely longer than the record call of 140 links (92.4 feet). The Harrison monument and railroad were both removed. The stone at corner 2 was also removed and replaced with a Harrison monument set at the position of the high point of the stone. The stone at corner 1 was left in place. The specific position of corner 1 was determined at 92.6 feet along the prolongation of the range line from the standard corner 1/2 mile north through the stone at corner 2. This point fell slightly east of the high point of the stone. A 15 inch diameter section of HDPE storm pipe was notched and set vertically over and amongst the stone. The stone was encased in concrete and the Harrison monument was set at the calculated point slightly east of the high point of the stone. It is noted that typically the closing corner is shifted to fit to the range line, per the procedures of the original federal surveyors. However, in this case it is clear the stone at corner 2 was established first per the bearing trees and that the stone at corner 1 was established relative to corner 2. Hence, in this particular case, corner 2 was held as the dominant corner for purposes of establishing the range line, though given that corner 1 was established along the prolongation of the line from the north through corner 2, the bend in the range line occurs at corner 1, as is typical. Corner 2 falls on the range line with no bend at that point.

No stone was found near the 1/2 inch rebar called for in the 1994 tie card. An adjoining land owner stated that a large rock had been visible above ground at that point but was removed many years ago.

Corner 1 was established in October, 1819 and corner 2 was originally established in June, 1822.

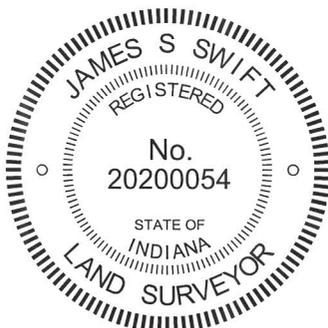

Kenneth E. Hedge
Kenneth E. Hedge, County Surveyor

James S. Swift
James S. Swift, IN LS 20200054
February 5, 2015

Washington Township	Clinton Township
Section 1 T19N, R1W	Section 6 T19N, R1E
Section 12 T19N, R1W	Section 7 T19N, R1E

PHOTOGRAPHIC DOCUMENTATION

Date of photography: October 22-29, 2013

View from above showing the stone at the closing corner and the railroad rail.



The closing corner and the fence to the north.



View from above the stone at the closing corner, looking east along C.R. 500 North.



The stone at the standard corner, and the harrison monument found. See documentation.



The stone at the standard corner. View from above and west.



For details and documentation, refer to related sheet "Section Corner Record."

SECTION CORNER RECORD

NE 500-050

BOONE COUNTY SURVEYOR'S OFFICE

State Plane grid coordinates NAD83 (CORS96):
North: 1772080.80 East: 3127182.04 (U.S. survey feet)

Type of monument: Harrison, 4" disk 'Section Corner'
Depth: One inch below adjacent road surface

Indiana tie card references:
IN02_T19NR1E06_36
IN02_T19NR1E07_04




CORNER WITNESS DETAIL

SCALE 1" = 30'

- A - Mag nail set in S. side, wood post, 2' a.g., 14.72'
- B - Boone County witness mark, flush, 21.37'
- C - Boone County witness mark, flush, 21.28'
- D - Mag nail set in N. side, wood post, 16.84'


Boone County witness mark is a 3/8" diameter x 2' long rebar bearing a metal cap stamped "Boone County Witness Point."

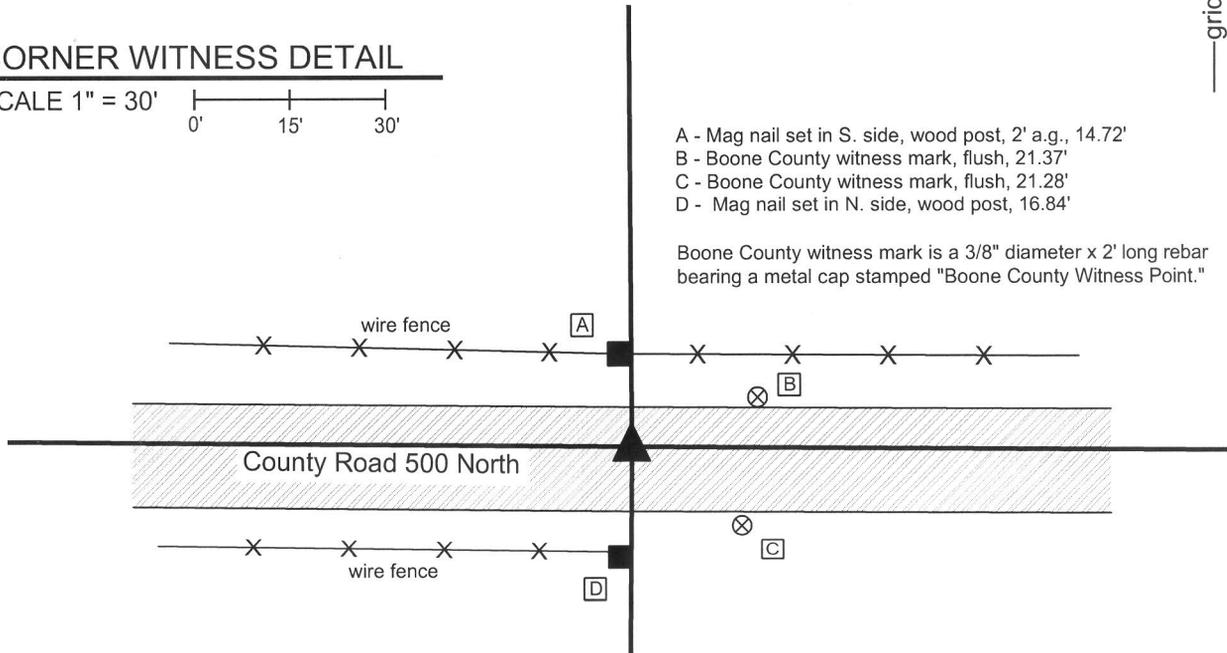

The harrison monument was set over a stone found.

A BCS record of May 9, 1872 states "Reestablished from Sycamore. Set Rock 11.7.51/2 +." A BCS tie card dated July 16, 1975 states "no stone found set rod." A BCS tie card dated August 2, 2005 shows the corner as a harrison monument with no documentation of source.

This corner was excavated on November 12, 2013. Prior to excavation, a harrison monument was found 2 inches deep in a hole in the asphalt road. Excavation revealed a stone found at 11 inches. The stone appeared to be leaning slightly towards the southwest. With the top 6 inches of the stone exposed it measured 7 inches N-S by 5 1/2 inches E-W. A vague mark was visible on the east edge of the stone. The stone was embedded in the clay layer below the road bed with the top of the stone at the bottom of the road bed. The stone was accepted as being the monument described in the 1872 record and was held as marking the corner. The stone was left in place and a harrison monument was set over the top of the stone at the apparent position which would have been the center of mass of the stone before it was leaned slightly southwest. The harrison monument found prior to excavation had been 1.2 feet south and 1.5 feet west of the stone. This corner was originally established as a wood post in 1822.

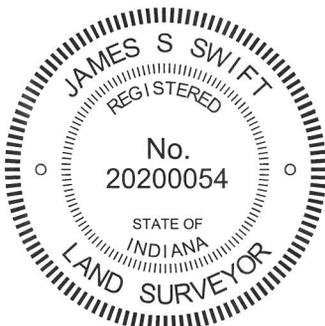

Kenneth E. Hedge, County Surveyor

James S. Swift, IN LS 20200054
February 5, 2015

Clinton Township

Section 6
T19N, R1E



Section 7
T19N, R1E

PHOTOGRAPHIC DOCUMENTATION
Date of photography: November 12, 2013

The stone as first exposed.
View from above and south.




View of the stone from above and east.



The stone, slightly east of the post on the south side of the road.



View from above the stone looking west along County Road 500 North.

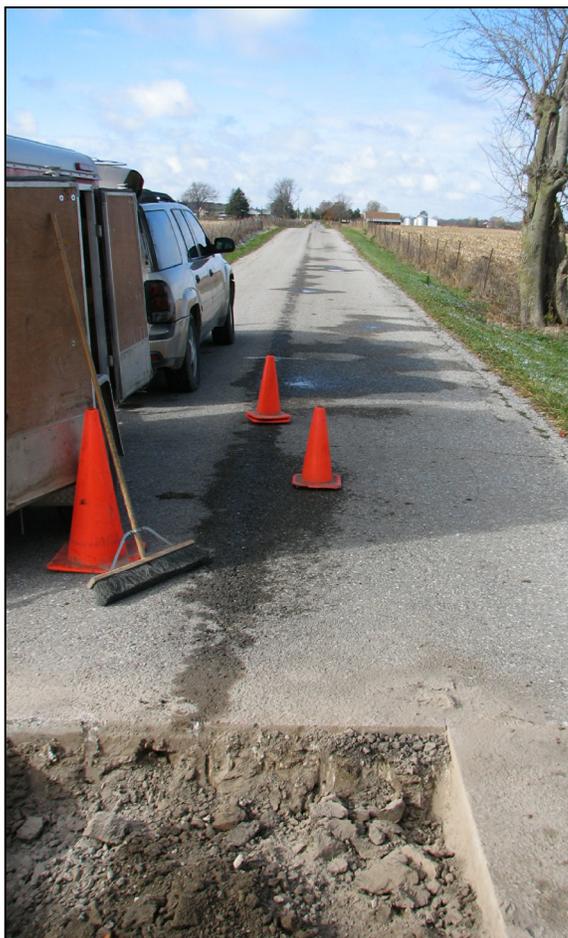

For details and documentation, refer to related sheet "Section Corner Record."

SECTION CORNER RECORD

NE 500-100

BOONE COUNTY SURVEYOR'S OFFICE

State Plane grid coordinates NAD83 (CORS96):

North: 1772060.68 East: 3129821.84 (U.S. survey feet)

Type of monument: Harrison, 4" disk 'Section Corner'

Depth: six inches below adjacent gravel road surface

Indiana tie card references:

IN02_T19NR1E06_80 IN02_T19NR1E05_72


IN02_T19NR1E07_08 IN02_T19NR1E08_00



CORNER WITNESS DETAIL

SCALE 1" = 30'

- A - Boone County witness mark, flush, 28.23'
- B - Mag nail set in W. side power pole, 1' a.g., 11.97'
- C - Boone County witness mark, flush, 20.82'

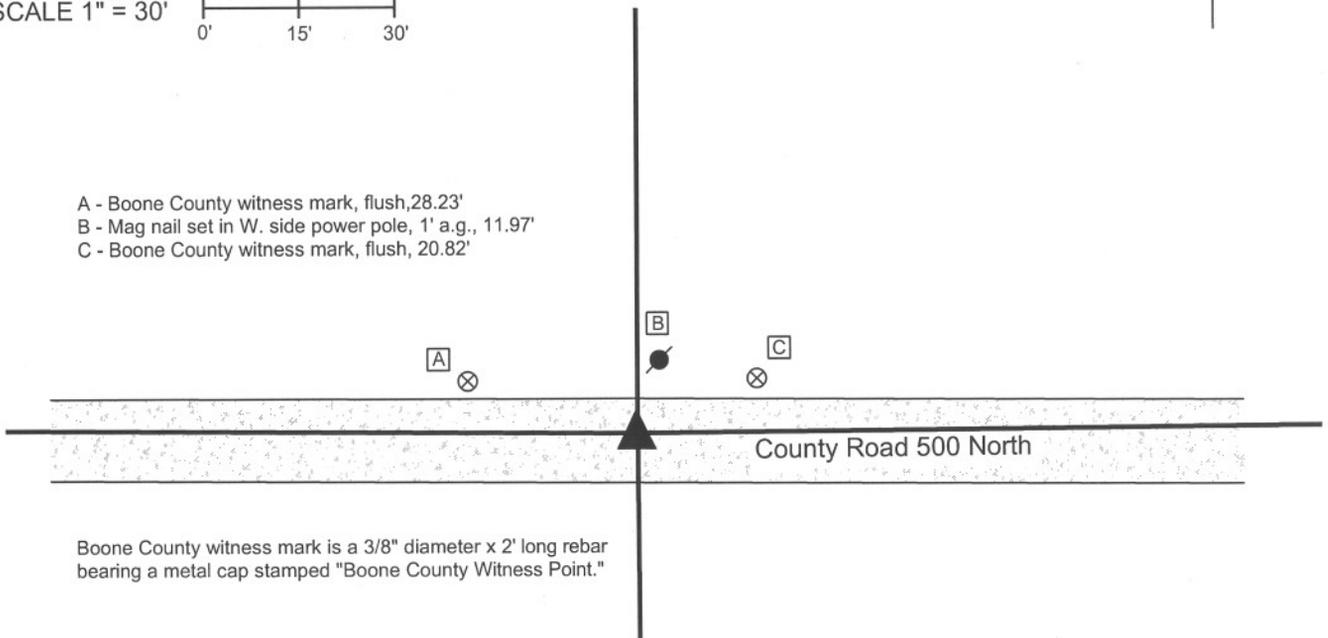


Boone County witness mark is a 3/8" diameter x 2' long rebar bearing a metal cap stamped "Boone County Witness Point."

The harrison monument was set in place of a harrison monument found.

No specific descriptions of this corner were found in the BCS Surveyor's Record. A BCS tie card dated September 29, 2005 shows the corner as a harrison monument with no documentation of source.

This corner was excavated on June 19, 2012. Prior to excavation a harrison monument was found which fit with the 2005 distance ties. Excavation of an area extending 4 feet north, 5 feet east, 4 feet south and 4 feet west of the harrison monument revealed no further evidence of the corner. The road bed is only 6 inches in this area. The harrison monument fit with local evidence in the form of the center of the county road to the east and west and the broken-off wood post on the north side of the road. The position of the found harrison was held as the corner. The found harrison monument was removed during excavation and replaced with a new harrison in the same position.

This corner was originally established as a wood post in June, 1822.

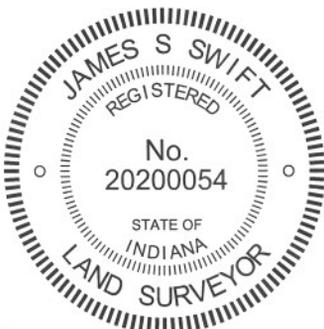

Kenneth E. Hedge, County Surveyor

James S. Swift, IN LS 20200054
January 15, 2013

Clinton Township

Section 6 T19N, R1E	Section 5 T19N, R1E
Section 7 T19N, R1E	Section 8 T19N, R1E