SECTION CORNER RECORD

NE 700-550

BOONE COUNTY SURVEYOR'S OFFICE

State Plane grid coordinates NAD83 (CORS96):
North: 1783031.31 East: 3153304.42 (U.S. survey feet)

Type of monument: Harrison, 4" disk 'Section Corner'
Depth: One inch below adjacent road surface

Indiana tie card references:
IN02_T20NR1E25_76
IN02_T20NR1E36_04

CORNER WITNESS DETAIL

SCALE 1" = 40'

0' 20' 40'

A - Mag nail set in S. side, power pole, 2' a.g., 153.7'
B - Boone County witness mark, flush, 27.2'
C - Boone County witness mark, flush, 15.9'

Boone County witness mark is a 3/8" diameter x 2' long rebar bearing a metal cap stamped "Boone County Witness Point."

The Harrison monument was set in place of a vertical section of railroad rail found.
An undated record in the BCS Surveyor's Record states, with respect to this corner, "Established by intersecting lines 'C' 'b' with lines '6' and '5' in sect 25, T20N, R1E. Set rock + 8,18,20 in road." It is noted that 'C' and 'b' refer to the corners approximately 1/2 and 1/4 miles east, respectively, of the subject corner and that '6' and '5' refer to intermediate corners between the subject corner and the center quarter corner of section 25.
A BCS tie card dated August 20, 1968 states "Found Stones."
This corner was excavated on May 29, 2015. Prior to excavation, the top of a vertical section of railroad rail was visible in a shallow hole in the center of the asphalt roadway. Excavation of a small area around the railroad rail revealed no further evidence of the corner. It is believed that the stones found in 1968 were removed and replaced with the railroad rail at that time. This is known to have been a common practice of BCS field crews in the late 1960s.
The position of the top of the rail, as originally found, was held as marking the corner. The rail was removed and replaced with a Harrison monument in the same position.
This corner was originally established as a wood post in 1822.

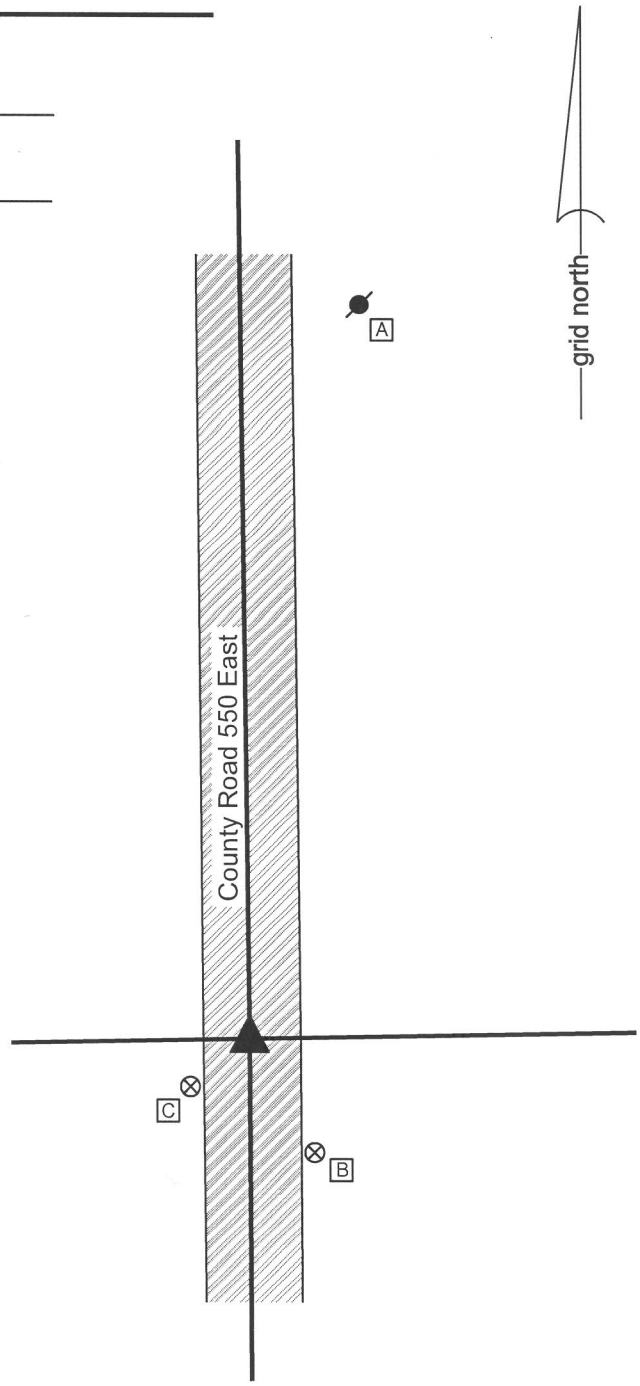

JAMES S SWIFT
REGISTERED
No. 20200054
STATE OF INDIANA
LAND SURVEYOR

Kenneth E. Hedge, County Surveyor

James S. Swift, IN LS 20200054
March 27, 2015

Clinton Township

Section 25
T20N, R1E

Section 36
T20N, R1E