SECTION CORNER RECORD

SW 700-300

BOONE COUNTY SURVEYOR'S OFFICE

State Plane grid coordinates NAD83 (CORS96):
North: 1708203.56 East: 3109308.43 (U.S. survey feet)

Type of monument: Drill hole on top, center of stone
Depth: flush with adjacent ground

Indiana tie card references:
IN02_T17NR1W04_80 IN02_T17NR1W03_72
IN02_T17NR1W09_08 IN02_T17NR1W10_00

grid north

A - Mag nail set in E. side power pole, 1.5' a.g., 9.38'
B - N. edge, round concrete post, 1' a.g., 19.00'
C - Mag nail set in W. side power pole, 2' a.g., 49.21'

Boone County witness mark is a 3/8" diameter x 2' long rebar bearing a metal cap stamped "Boone County Witness Point."

- wire fence

CORNER WITNESS DETAIL

SCALE 1" = 40'

0' 20' 40'

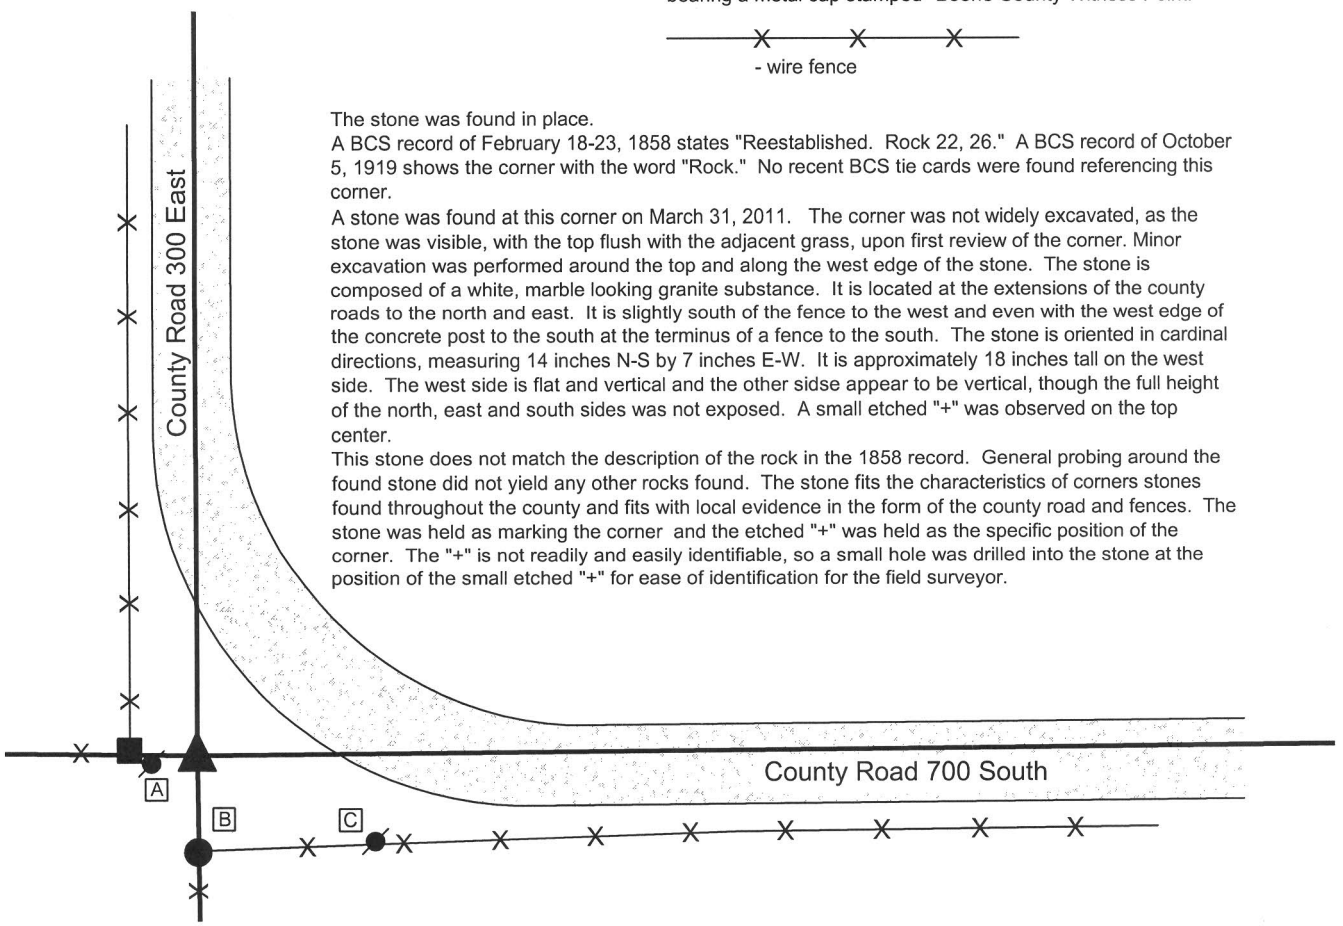

The stone was found in place.
A BCS record of February 18-23, 1858 states "Reestablished. Rock 22, 26." A BCS record of October 5, 1919 shows the corner with the word "Rock." No recent BCS tie cards were found referencing this corner.
A stone was found at this corner on March 31, 2011. The corner was not widely excavated, as the stone was visible, with the top flush with the adjacent grass, upon first review of the corner. Minor excavation was performed around the top and along the west edge of the stone. The stone is composed of a white, marble looking granite substance. It is located at the extensions of the county roads to the north and east. It is slightly south of the fence to the west and even with the west edge of the concrete post to the south at the terminus of a fence to the south. The stone is oriented in cardinal directions, measuring 14 inches N-S by 7 inches E-W. It is approximately 18 inches tall on the west side. The west side is flat and vertical and the other sidse appear to be vertical, though the full height of the north, east and south sides was not exposed. A small etched "+" was observed on the top center.
This stone does not match the description of the rock in the 1858 record. General probing around the found stone did not yield any other rocks found. The stone fits the characteristics of corners stones found throughout the county and fits with local evidence in the form of the county road and fences. The stone was held as marking the corner and the etched "+" was held as the specific position of the corner. The "+" is not readily and easily identifiable, so a small hole was drilled into the stone at the position of the small etched "+" for ease of identification for the field surveyor.

JAMES S SWIFT
REGISTERED
No.
20200054
STATE OF
INDIANA
LAND SURVEYOR

Kenneth E. Hedge, County Surveyor

James S. Swift, IN LS 20200054

March 30, 2012, Revised March 7, 2013

Harrison Township

Section 4 T17N, R1W	Section 3 T17N, R1W
Section 9 T17N, R1W	Section 10 T17N, R1W

BOONE COUNTY SURVEYOR'S OFFICE

SW 700-300

PHOTOGRAPHIC DOCUMENTATION
Date of photography: March 31, 2011 & December 2, 2011

View of the stone with the west side partially exposed. March 31, 2011.

View from above, showing the stone and the hole drilled into the top. December 2, 2011.

View from the west, looking across the stone and east along County Road 300 South.

View from the north, looking across the stone and south to the concrete post at the terminus of a north-south fence.

For details and documentation, refer to related sheet "Section Corner Record."