

SECTION CORNER RECORD

BOONE COUNTY SURVEYOR'S OFFICE

NE 100-1100

State Plane grid coordinates NAD83 (NSRS 2007):

North: 1752095.57 East: 3183077.20 (U.S. survey feet)

Type of monument: Harrison, 4" disk 'Section Corner'

Depth: Six inches below adjacent gravel road surface.



Indiana tie card references:

IN02_T19NR2E25_72 IN02_T19NR2E26_80

IN02_T19NR2E35_08 IN02_T19NR2E36_00

CORNER WITNESS DETAIL

SCALE 1" = 40'

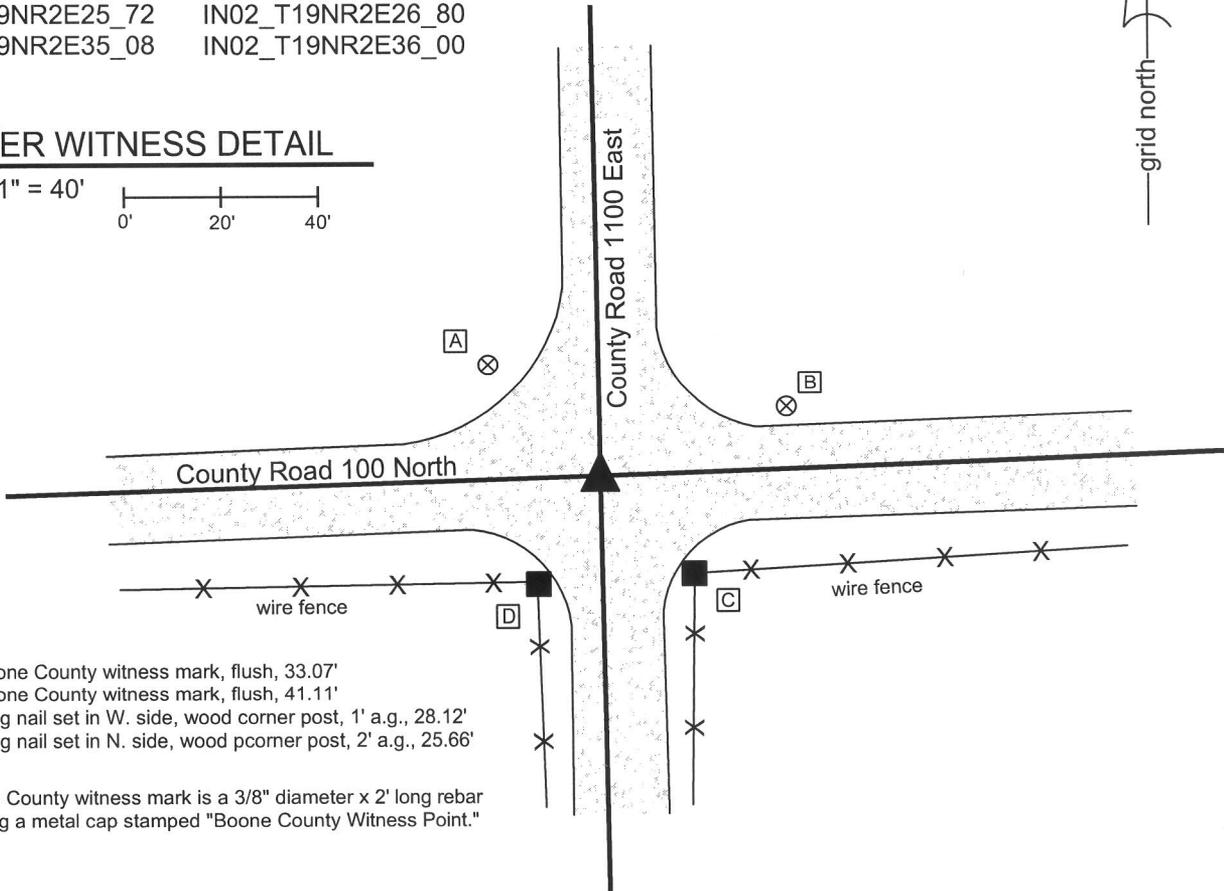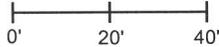

- A - Boone County witness mark, flush, 33.07'
- B - Boone County witness mark, flush, 41.11'
- C - Mag nail set in W. side, wood corner post, 1' a.g., 28.12'
- D - Mag nail set in N. side, wood pcorner post, 2' a.g., 25.66'


Boone County witness mark is a 3/8" diameter x 2' long rebar bearing a metal cap stamped "Boone County Witness Point."

The harrison monument was set directly over the etched "+" on a stone found.

A BCS record of October 24, 1866 states "Re-Established after having taken additional evidence. Set two Rocks, one 6.5.4 in + Mark on top. Top Rock 13.7.5 1/2 + on top." A BCS tie card dated August 7, 1974 states "No stone found."

This corner was excavated on June 18, 2010. Prior to excavation, a railroad rail was found at 4 inches deep. Excavation revealed a rock found at 24 inches deep, 1 foot west of the rail. The rock was 12 inches N-S by 10 inches E-W by 8 inches tall. A deep crease was visible on the top of the rock but did not appear to be an intentional mark. This stone did not match the description of either of the record stones and was removed. Further excavation revealed the record bottom stone found at 28 inches deep. This stone had a clearly visible etched "+" on the top. The stone matches the proportions of the record bottom stone, but was slightly larger in all dimensions. The top of the stone is approximately 10 inches deep into the clay layer below the road. A 13 inch tall stone above it would have protruded 3 inches into the bottom of the road bed, which is consistent with the depth of many other stones found. The stone was left in place and the harrison monument was set over the etched "+" on the top. The harrison is 0.9 foot north and 2.9 feet west of the position of the railroad rail, which was removed during excavation. The 1968 reference to "no stone found" indicates that a stone was searched for but not found. It is most likely that the railroad rail was set at that time, after the erroneous determination that other evidence, in the form of a stone, was not present.

This corner was originally established as a wood post in June, 1821.

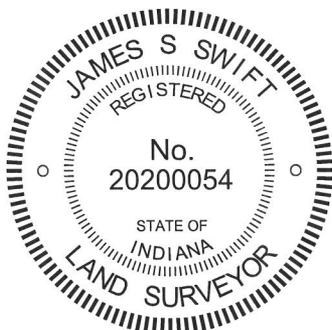

Kenneth E. Hedge
 Kenneth E. Hedge, County Surveyor

James S. Swift
 James S. Swift, IN LS 20200054
 July 25, 2011

Union Township

Section 26 T19N, R2E	Section 25 T19N, R2E
Section 35 T19N, R2E	Section 36 T19N, R2E

PHOTOGRAPHIC DOCUMENTATION

Date of photography: June 18, 2010

View of the stone from above.



Close-up of the stone.



For details and documentation, refer to related sheet "Section Corner Record."

SECTION CORNER RECORD

NE 100-1150

BOONE COUNTY SURVEYOR'S OFFICE


State Plane grid coordinates NAD83 (NSRS 2007):
North: 1752187.42 East: 3185748.55 (U.S. survey feet)

Type of monument: Harrison, 4" disk 'Section Corner'
Depth: Six inches below adjacent gravel road surface.


Indiana tie card references:
IN02_T19NR2E25_76
IN02_T19NR2E36_04

CORNER WITNESS DETAIL

SCALE 1" = 30'

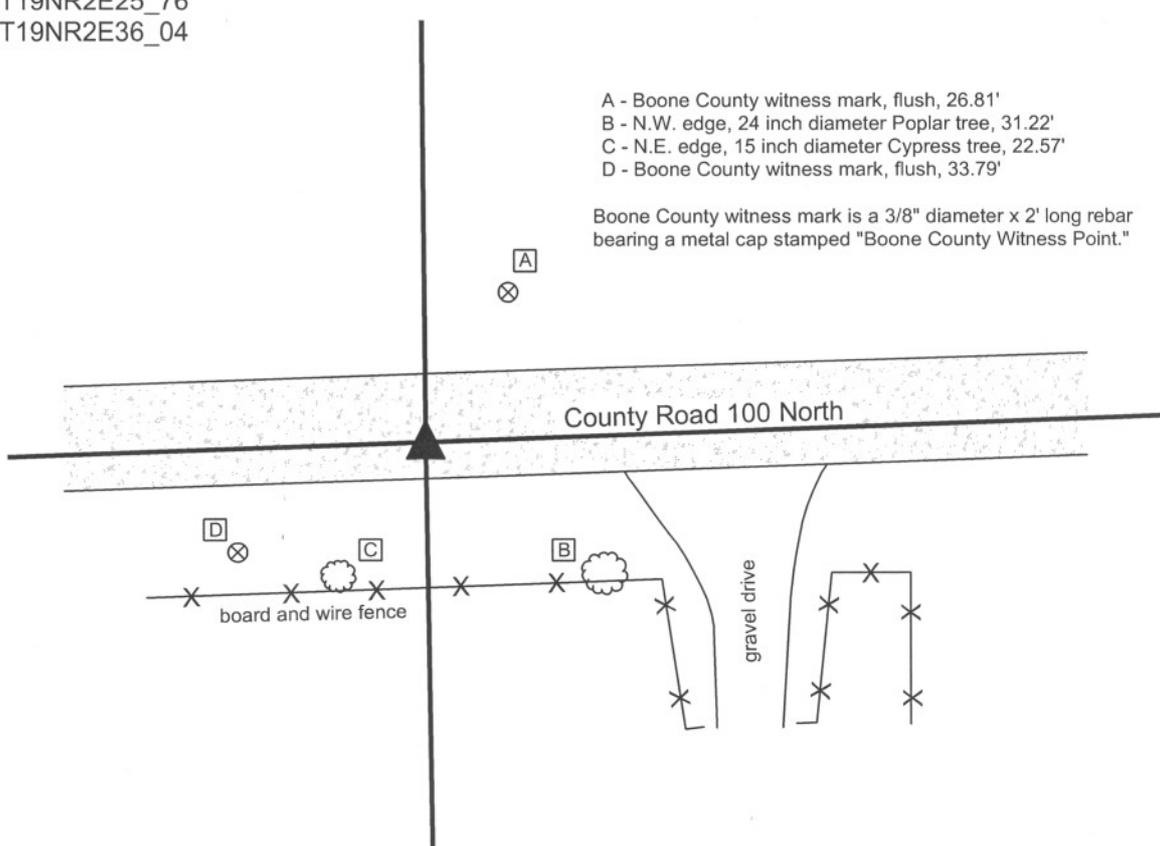

The harrison monument was set in place of a stone found. No specific descriptions of this corner were found in the BCS Surveyor's Record, nor were any recent tie cards found for this corner. Prior to excavation a 5/8 inch diameter rebar with a red cap was found near the south edge of the roadway at 7 inches deep. No source information was found for this rebar and the markings on the cap were not legible. Excavation revealed a stone found at 3 inches deep, north and east of the rebar. An etched "+" was visible on the top of the stone, though the top of the stone appeared to have been scraped by a road grader and the mark was not deeply etched. The stone was 14 inches N-S by 11 inches E-W by 14 inches tall. The bottom eight inches of the stone were embedded in the clay layer below the road and the top of the stone protruded 6 inches into the bottom of the road bed. It is noted that the road appears to have been cut slightly in this area and it is estimated that the depth of the stone would have been 13 to 15 inches prior to the cut. The stone was removed and the harrison monument was set in its place. The harrison monument is 3.2 feet north and 2.0 feet east of the former position of the rebar, removed during excavation. This corner was originally established as a wood post in June, 1821.

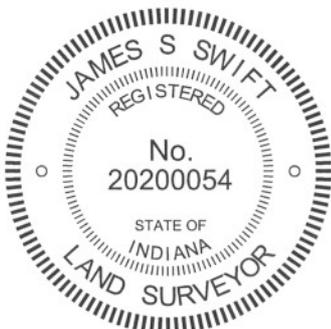

Kenneth E. Hedge
Kenneth E. Hedge, County Surveyor

James S. Swift
James S. Swift, IN LS 20200054
July 25, 2011

Union Township

Section 25
T19N, R2E

Section 36
T19N, R2E

SECTION CORNER RECORD

BOONE COUNTY SURVEYOR'S OFFICE

NE 100-1200

State Plane grid coordinates NAD83 (CORS96):

Corner 1: North: 1752280.02 East: 3188412.48 (U.S. survey feet)
 Corner 2: North: 1752246.68 East: 3188412.40 (U.S. survey feet)

Type of monument: Harrison, 4" disk 'Section Corner'
 Depth: One inch below adjacent road surface

Indiana tie card references:
 IN02_T19NR2E25_80 IN02_T19NR3E30_72
 IN02_T19NR2E36_08 IN02_T19NR3E31_00

- ① S.E. Corner, Section 25
 N.E. Corner, Section 36
 T 19 N, R 2 E
 Boone County corner
- ② S.W. Corner, Section 30
 N.W. Corner, Section 31
 T 19 N, R 3 E
 Hamilton County corner

Distance between monuments: 33.33'
 Original federal closing: 50 links (33')


CORNER WITNESS DETAIL

SCALE 1" = 40'

- A - Mag nail in S. side power pole, 1.5' a.g.,
 56.45' to corner 1, 93.53' to corner 2
- B - Boone County witness mark, flush,
 45.97' to corner 1, 78.82 to corner 2
- C - Mag nail set in S.W. side power pole, 1.8' a.g.,
 132.52' to corner 1, 99.56' to corner 2
- D - Boone County witness mark, flush
 83.55' to corner 1, 50.80' to corner 2
- E - Mag nail in N. side power pole, 8 in. a.g.
 32.34' to corner 1, 18.00' to corner 2

Boone County witness mark is a 3/8" diameter x 2' long rebar bearing a metal cap stamped "Boone County Witness Point."


The harrison monuments were set over stones found.
 A BCS record of October 23-24, 1866 states "Reestablished 50 links North of corner for Hamilton County found a stake where set Rock 20.11 by 7 in. marked + place a Rock under it 3 1/2, 2 1/2, 2 in."
 A BCS tie card dated August 14, 1967 states "no stone."
 Both corners were excavated in cooperation with the Hamilton County Surveyor's Office, with Joe Mullins, LS and other representatives of that office present at the time of excavation.
 Prior to excavation, a nail was found at 3 inches deep in the center of the northern intersection. No monument was found at the southern intersection. Excavation at corner 1 revealed a bent piece of rebar below the nail. Further excavation revealed a stone found at 17 inches deep. The main shaft of the rebar was along the north edge of the stone. With 8 inches of the stone exposed it measured 10 inches E-W by 6 inches N-S. The stone appeared to be vertical and well embedded in the clay layer below the road bed, protruding approximately 4 inches into the bottom of the road bed. A clearly visible etched "+" mark was visible on the west side of the stone, 3 inches below the top. The stone was accepted as being the rock described in the 1866 record. A harrison monument was set over the top, high point of the stone, in line with the etched "+" on the west side. The nail and main shaft of the rebar had both been on the north edge of the stone, 3 inches north of the top, center.
 Excavation at corner 2 revealed a stone found at 20 inches deep. The stone had a clearly visible mark of "S31" with lines etched on the north and west sides of the writing. With 3 inches of the top of the stone exposed, it measured 10 inches N-S by 8 inches E-W. This stone is not known to be specifically described in the Hamilton County records, but clearly marks the corner. A harrison monument was set over the 90° angle point where the lines on the north and west sides of the writing intersect. This point is 33.3 feet south of corner 1 and is approximately 0.4 foot west of the range line as defined by the standard corners.

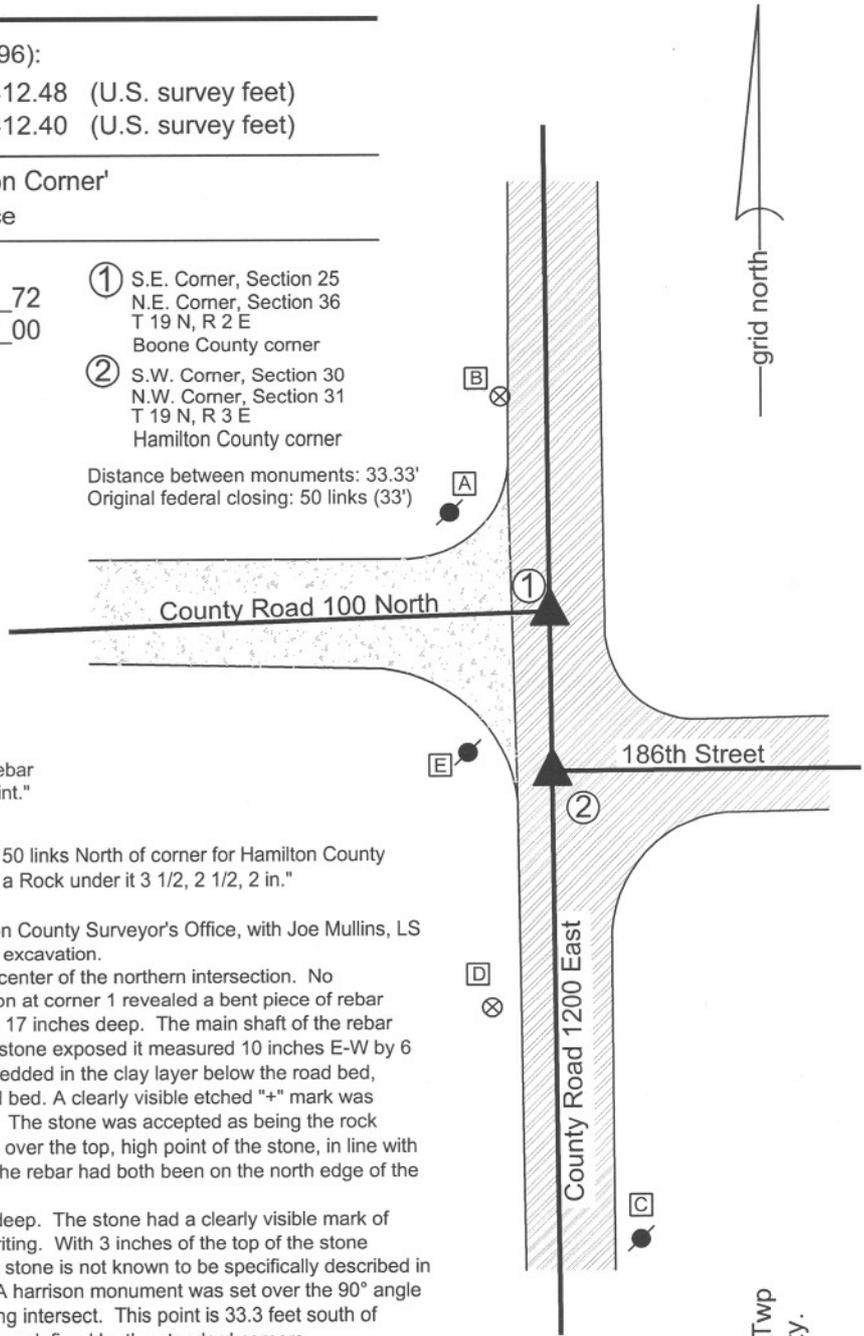

Union Twp.
Boone Cnty.

Washington Twp.
Hamilton Cnty.

Section 25 T19N, R2E	Section 30 T19N, R3E
Section 36 T19N, R2E	Section 31 T19N, R3E

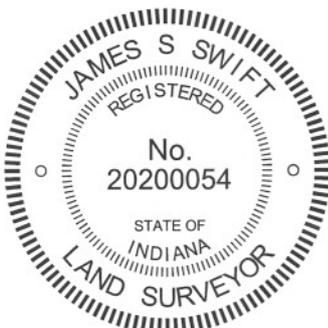

Kenneth E. Hedge
 Kenneth E. Hedge, County Surveyor

James S. Swift
 James S. Swift, IN LS 20200054
 January 15, 2013

PHOTOGRAPHIC DOCUMENTATION

Date of photography: July 17, 2012


View of the stone at the Boone County corner (corner 1) and the adjacent rebar from the north.



View of the stone at corner 1 from above and from the west.



View of the stone at corner 1 from the north, looking south across the Hamilton County corner and along the County Line Road.

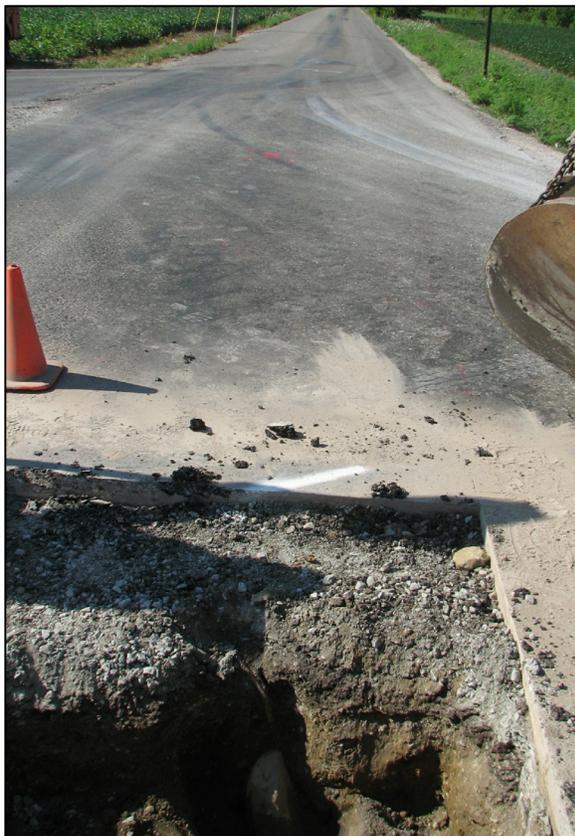

The stone at the Hamilton County corner (corner 2) as found.



The stone at corner 2 with paint.



For details and documentation, refer to related sheet "Section Corner Record."