

# SECTION CORNER RECORD

NE 500-350

## BOONE COUNTY SURVEYOR'S OFFICE

State Plane grid coordinates NAD83 (CORS96):  
North: 1772208.68 East: 3142939.97 (U.S. survey feet)

Type of monument: Harrison, 4" disk 'Section Corner'  
Depth: six inches below adjacent gravel road surface

Indiana tie card references:  
IN02\_T19NR1E03\_76  
IN02\_T19NR1E10\_04



### CORNER WITNESS DETAIL

SCALE 1" = 40'  
0' 20' 40'

- A - East edge 10 inch diameter pine tree, 41.5'
- B - Boone County witness mark, flush, 34.72'
- C - Boone County witness mark, flush, 33.44'
- D - East edge, 10 inch diameter pine tree, 21.9'

Boone County witness mark is a 3/8" diameter x 2' long rebar bearing a metal cap stamped "Boone County Witness Point."


The harrison monument was set in place of a stone found.  
 A BCS record of March 10, 1852 states "a stone." A undated BCS tie card, likely from the late 1960s, states "no stone." A BCS tie card dated June 15, 1975 states "no stone found - set rod."  
 This corner was excavated on June 15, 2012. Prior to excavation, a railroad rail was found at the surface, generally vertical though leaning slightly towards the northwest. Excavation revealed a stone found at the surface, 3.6 feet north and 2.6 feet east of the rail. The stone had a distinct flat, top area measuring approximately 4 inches by 4 inches. The stone was removed and found to be 22 inches tall, 13 inches E-W by 11 inches N-S, as found. The stone was vertical and well embedded in the clay layer below the road bed, protruding approximately 6 inches out of the clay into the road bed. The total road bed is approximately 6 inches deep. No specific marks were found on the stone. It is noted that, given the position of the stone at the surface of the gravel road, any mark which may have been on the top, flat area would have been scraped off by road grading equipment. The stone was in the center of the north-south road, whereas the rail had been slightly to the west of the center. The stone was in line with the brush line to the east, though the two previous tie cards showed the corner as being in line with a fence to the east. The stone was held as marking the corner. The stone was removed and replaced with a harrison monument in the same position as the center of the flat top of the stone.  
 This corner was originally established as a wood corner post in 1822.

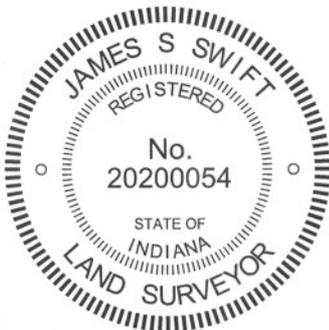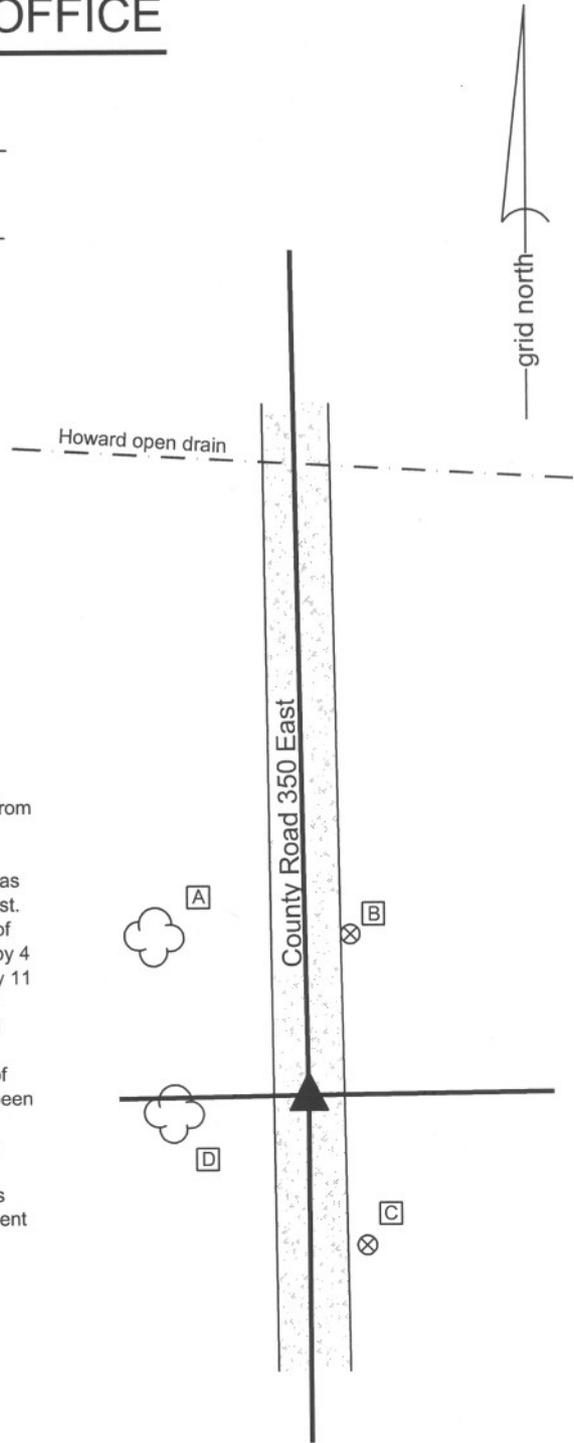

*Kenneth E. Hedge*  
 Kenneth E. Hedge, County Surveyor

*James S. Swift*  
 James S. Swift, IN LS 20200054  
 January 15, 2013

Clinton Twp

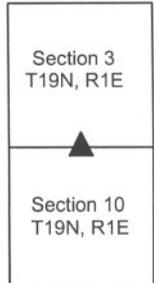

PHOTOGRAPHIC DOCUMENTATION

Date of photography: June 15, 2012

View of the stone from above and west.



View of the stone from above.



View from the south, looking across the stone and north along County Road 350 East.



View of the stone from the west. Note the railroad rail, removed during excavation.



For details and documentation, refer to related sheet "Section Corner Record."

# SECTION CORNER RECORD

NE 550-300

## BOONE COUNTY SURVEYOR'S OFFICE

State Plane grid coordinates NAD83 (CORS96):

North: 1774813.74 East: 3140306.40 (U.S. survey feet)

Type of monument: Harrison, 4" disk 'Section Corner'

Depth: two inches above adjoining ground


Indiana tie card references:

IN02\_T19NR1E04\_44


IN02\_T19NR1E03\_36

### CORNER WITNESS DETAIL

SCALE 1" = 20'

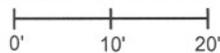

Harrison monument is at S.E. corner of wood post  
No other reference ties were established.

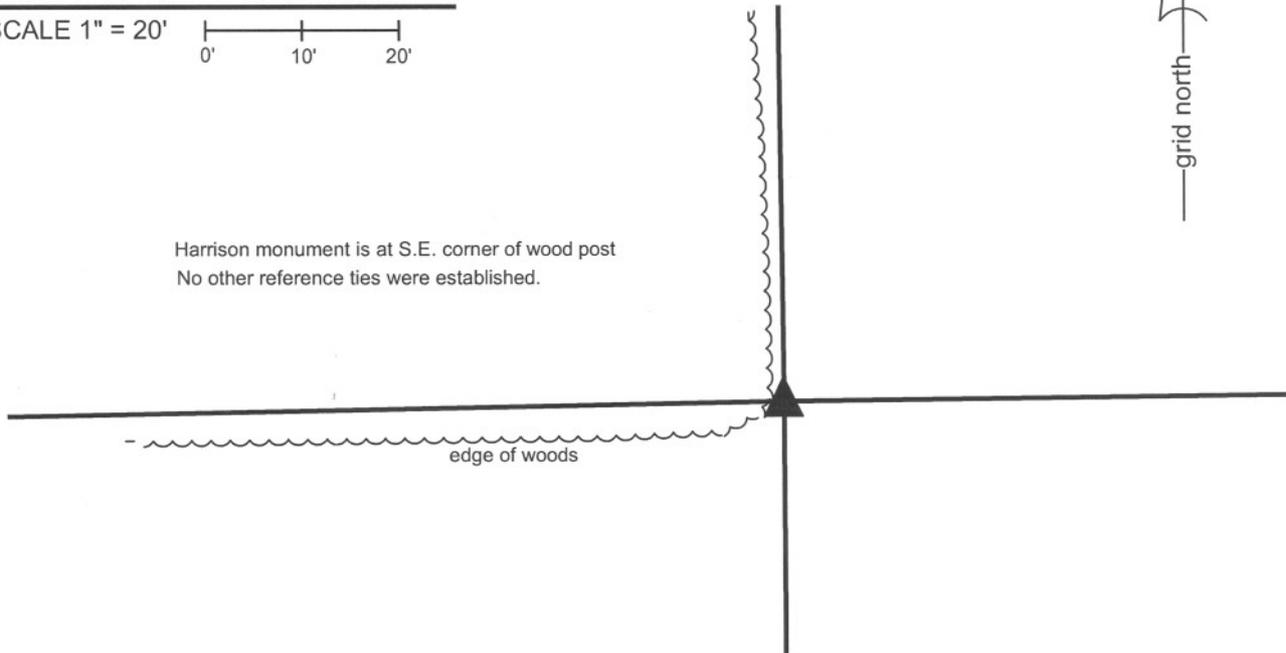


The harrison monument was set in place of a harrison monument found.

No specific descriptions of this corner were found in the BCS Surveyor's Record beyond the original establishment of the corner in 1822. A BCS tie card dated September 1, 1995 shows the corner as a rebar set on the south side of a corner post. A BCS tie card dated August 19, 2005 shows the corner as a harrison monument at the base of a fence corner post.

This corner was excavated on November 1, 2011. A harrison monument was found at the East edge of a wood corner post. The post was broken, as found, but was clearly the corner for fences to the north and west. The harrison monument was loose, broken off at 8 inches deep and leaning to the west. Various rocks were found around and near the post but none were identifiable as a section corner stone. As noted above, no specific descriptions of the corner were found in the old BCS Surveyor's Record. The harrison monument was replaced in the position of the monument as it would have been in a vertical orientation. A new harrison monument was set in a more stable manner.

This corner was originally established as a wood post in June, 1822.

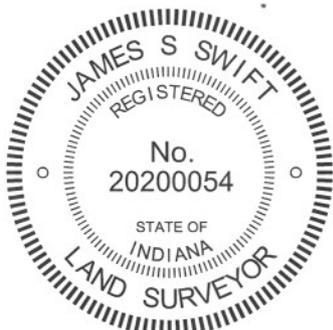

*Kenneth E. Hedge*  
Kenneth E. Hedge, County Surveyor

*James S. Swift*  
James S. Swift, IN LS 20200054  
March 1, 2012

Clinton Township

