SECTION CORNER RECORD NW 200-050

BOONE COUNTY SURVEYOR'S OFFICE

State Plane grid coordinates NAD83 (CORS96):
North: 1756172.41 East: 3122161.33 (U.S. survey feet)

Type of monument: Harrison, 4" disk 'Section Corner'
Depth: flush with adjacent ground

Indiana tie card references:
IN02_T19NR1W24_76
IN02_T19NR1W25_04

CORNER WITNESS DETAIL

SCALE 1" = 40' 0' 20' 40'

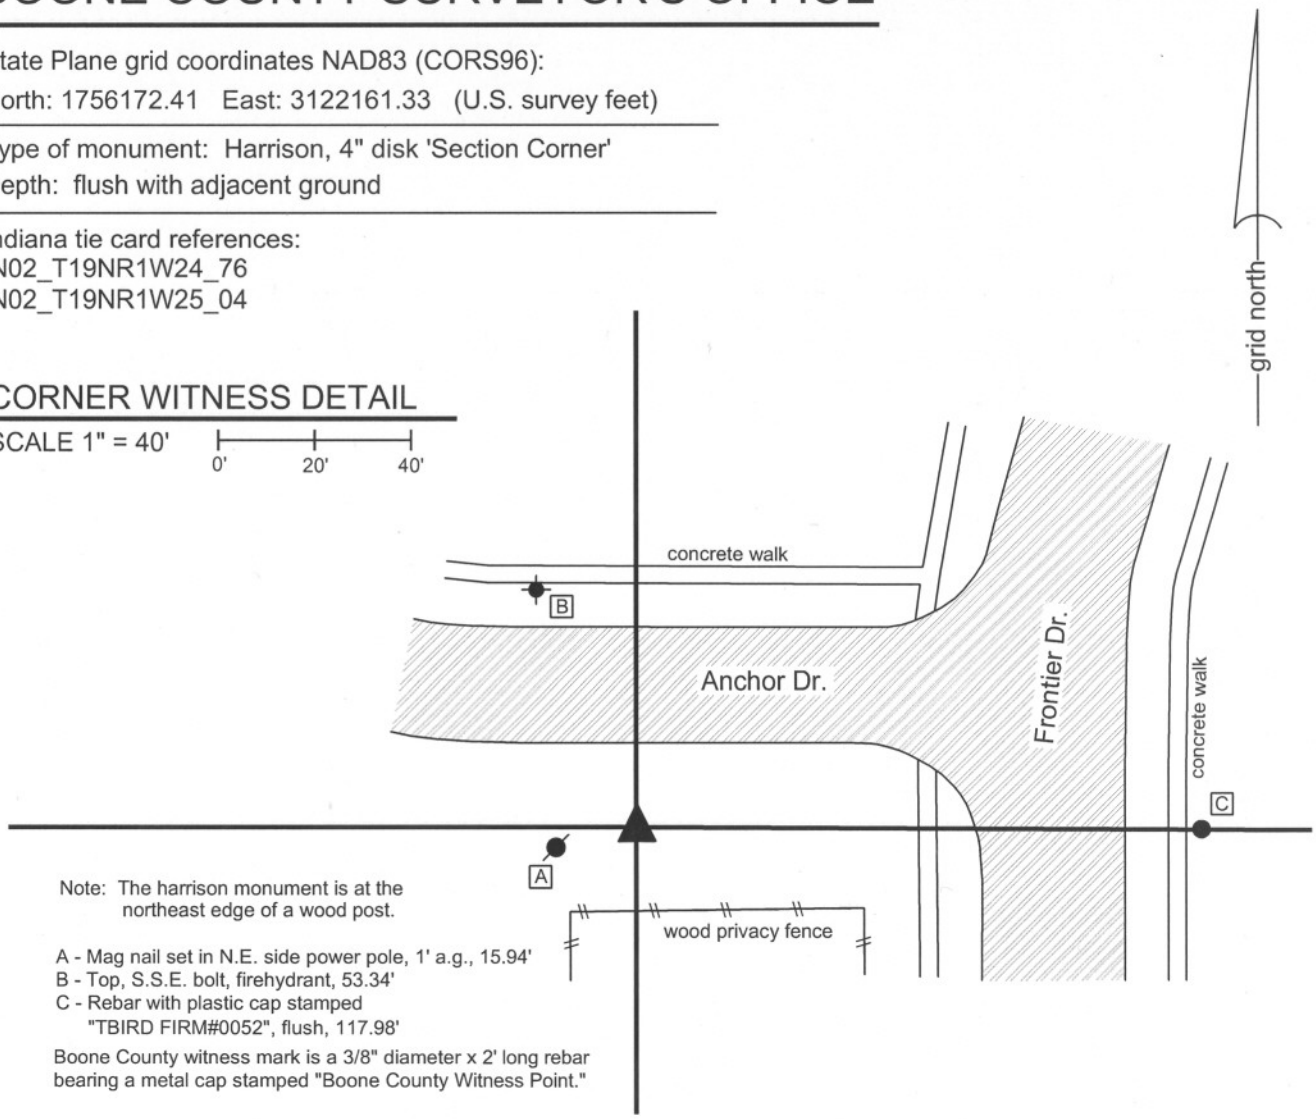

Note: The harrison monument is at the northeast edge of a wood post.

A - Mag nail set in N.E. side power pole, 1' a.g., 15.94'
B - Top, S.S.E. bolt, firehydrant, 53.34'
C - Rebar with plastic cap stamped "TBIRD FIRM#0052", flush, 117.98'

Boone County witness mark is a 3/8" diameter x 2' long rebar bearing a metal cap stamped "Boone County Witness Point."

The harrison monument was set in place of a stone found.
A BCS record of June 26-28, 1859 states "Reest'd from stump of one original B.Tree (B Oak). Set." No recent BCS tie cards were found referencing this corner. The corner was excavated on May 18, 2010. Excavation was performed in cooperation with Clem Kuhns, LS, of T-Bird Design, Lafayette IN. Mr. Kuhns had performed extensive preliminary surveying and provided information which was used in determining the corner. Prior to excavation an old wood post was clearly visible and a stone was known to exist at the east edge of the wood post, approximately 6 inches deep. As found, the stone measured 16 inches N-S by 9 inches E-W by 9 inches tall. The widest part of the stone was at the north end and it appeared that the stone may previously have been vertical but was knocked over towards the south. The 1859 record does not describe the stone, but it is known from discovery at other section corners that it is most likely that the stone would have been set vertically with the most substantial part of the stone at the bottom. The most likely apparent position for the corner is the point near the north edge of the stone which represents what might have been the position of the stone as it would have stood vertically. Mr. Kuhns confirmed that this position fit well with record and cominbed survey dimensions to the center quarter corner to the north (See NW-250-050), local monumentation to the east and interior improvements and evidence of corners in the Shaker Square development. This position was held as the corner and the harrison monument was set at that position. The stone was removed. The stone is shown as being found and held as marking the corner on several private surveys, including a survey by by Frank M. Hahn & Associates recorded in Survey Book 1, page 54 and a survey by the Schnieder Corporation recorded in Survey Book 3, pages 65-66, all in the Office of the Boone County Recorder.

JAMES S SWIFT
REGISTERED
No. 20200054
STATE OF INDIANA
LAND SURVEYOR

Kenneth E. Hedge, County Surveyor

James S. Swift, IN LS 20200054
Mach 30, 2012

Center Twp

Section 24
T19N, R1W

Section 25
T19N, R1W

BOONE COUNTY SURVEYOR'S OFFICE

NW 200-050

PHOTOGRAPHIC DOCUMENTATION
Date of photography: May 18, 2010

The stone and the bottom of the post.
View from the east.

The stone and the bottom of the post.
View from above.

The stone and the post.

For details and documentation, refer to
related sheet "Section Corner Record."