

BOONE COUNTY SURVEYOR'S OFFICE

SE 100-400

PHOTOGRAPHIC DOCUMENTATION Date of photography: August 11, 2009



View from the east, looking across the stone and west along County Road 100 South.




For details and documentation, refer to related sheet "Section Corner Record."

View of the stone more fully exposed.



View from the north, looking across the stone and south along County Road 400 East.




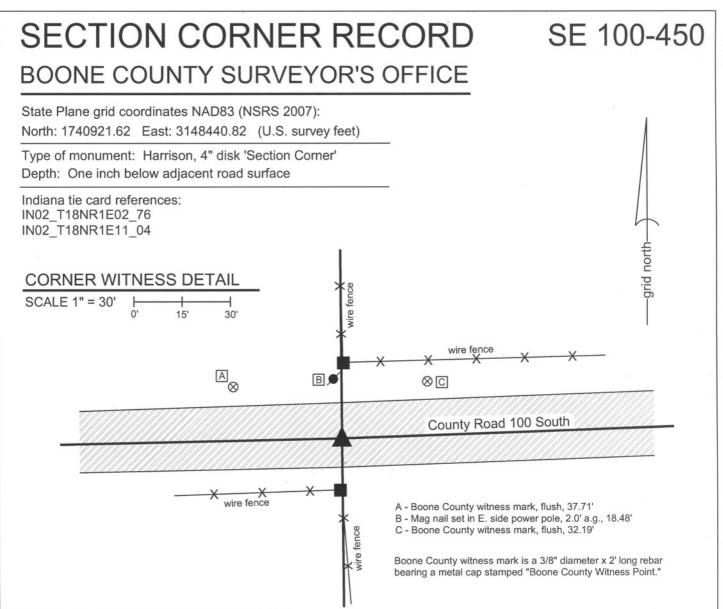


The harrison monument was set in place of a railroad rail found.

A BCS record of April 6, 1869 states "Disputed. Therefore chopped into Oak found mark. Set two Rocks. One 4,5,3 marked +. Top one 20.16.3 marked +." A BCS tie card dated October 8, 1971 states "Stone found. RRR put in." A BCS tie card dated October 15, 2005 shows the corner as a harrison monument with no documentation of source.

This corner was excavated on June 29, 2009. Prior to excavation, a harrison monument was visibile at the surface, leaning slightly and clearly disturbed. Excavation revealed a railroad rail at 9 inches deep. The rail was leaning slightly to the east. The harrison monument had been approximately 4 inches north and 3 inches west of the top of the rail. Due to the leaning characteristic of the rail, the E-W position of the harrison appeared to fit with the approximate bottom of the rail but the harrison was clearly north of the original position of the rail. No other evidence was found. Although the 1971 tie card does not specifically state it, it is most likely that the stone was removed at the time the railroad rail was set. It is noted that the 2005 tie card demonstrates a simlar tie distance as shown on the 1971 tie card to a post south of the corner. However, it was observed that the existing post appears to be newer than the posts to the south and west. No nail or other markings which appeared to be from the 1971 time frame were found in the post. It is believed that the post shown on the 2005 tie card is not the same as that shown on the 1971 tie card. No documentation was found explaining why the harrison was set at a position which is not in accordance with the rail. The new harrison monument was set in place of the rail, 4 inches south of the previously existing harrison. This corner was originally established as a wood post in June, 1820.

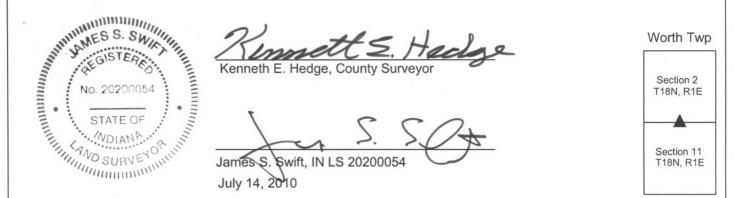

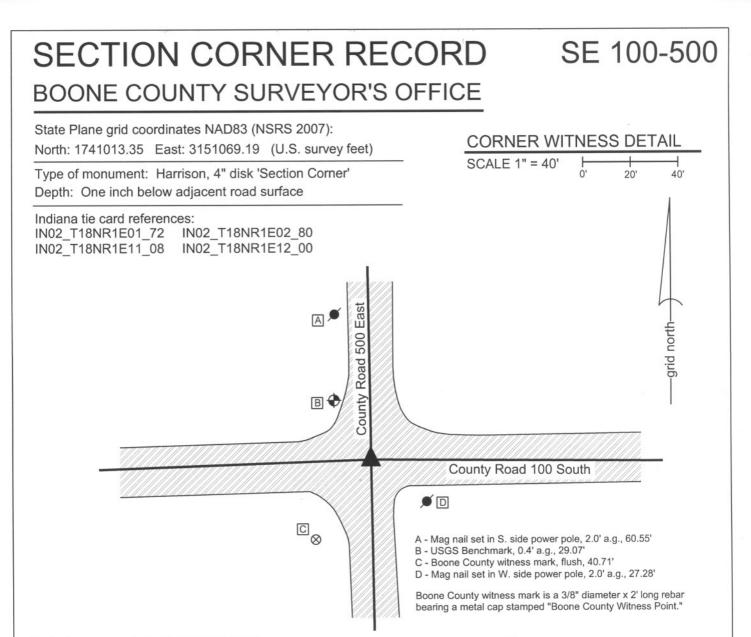

The harrison monument was set over a stone found.

A BCS record of April 6, 1869 states "Placed the Rock deeper 27,20,8 in ground." A BCS tie card dated August 16, 1967 states "no stone" and shows a position for the corner but does not document the monument set. A BCS tie card dated October 25, 2005 shows the corner as a harrison monument with no documentation of source.

This corner was excavated on July 16, 2009. Prior to excavation a harrison monument was visible at the surface. Excavation revealed a railroad rail found at 10 inches deep, approximately 2 inches SW of the position of the harrison monument. Although the record does not specify the monument, it is likely that the railroad rail was set on August 16, 1967. Further excavation revealed a stone found at 15 inches deep, north of the harrison and rail. The stone is clearly vertical, embedded in the clay layer below the road with 3 inches of the stone protruding out of the clay into the base layer of the road. With 12 inches of the stone exposed the stone measures 7 inches E-W by 16 inches N-S and appeared to be larger lower. Based on experience excavating similar monuments, it is reasonable to conclude that this is the record stone described in the 1869 record and that the E-W and N-S dimensions near the base of the stone will match the record dimensions of 8 inches and 20 inches, respectively. No specific markings were observed, nor were any noted in the record. The stone was left in place and the harrison monument was set over the top center point of the stone, 1.7 feet north and 0.2 feet east of the previous harrison.

This corner was originally established as a wood post in June, 1820.

mmm	MESS. SWAME Kennett S. Hedge	Worth Township	
	No. 20200054	Section 2 T18N, R1E	Section 1 T18N, R1E
	James S. Swift, IN LS 20200054 July 14 2010	Section 11 T18N, R1E	Section 12 T18N, R1E

BOONE COUNTY SURVEYOR'S OFFICE SE 100-500

PHOTOGRAPHIC DOCUMENTATION Date of photography: July 16, 2009



View of the stone from above and west.

View of the stone from above and south.



View from the west, looking across the stone and west along County Road 100 South.



For details and documentation, refer to related sheet "Section Corner Record."

View from the south, looking across the stone and north along County Road 500 East.

