

SECTION CORNER RECORD

BOONE COUNTY SURVEYOR'S OFFICE

NW 900-000

State Plane grid coordinates NAD83 (CORS96):

Corner 1: North: 1793138.65 East: 3124756.47 (U.S. survey feet)

Corner 2: North: 1793150.42 East: 3124756.44 (U.S. survey feet)

Type of monument: Harrison, 4" disk 'Section Corner'

Depth: six inches below adjacent gravel road surface

Indiana tie card references:

IN02_T20NR1W13_80 IN02_T20NR1E18_72

IN02_T20NR1W24_08 IN02_T20NR1E19_00

CORNER WITNESS DETAIL

SCALE 1" = 40'



① S.E. Corner, Section 13
N.E. Corner, Section 24
T 20 N, R 1 W


② S.W. Corner, Section 18
N.W. Corner, Section 19
T 20 N, R 1 E

Distance between corners = 11.77'

- A - Mag nail set in S.E. side power pole, 2' a.g., 100.8' to corner 1, 89.2' to corner 2
- B - Boone County witness mark, flush, 38.4' to corner 1, 27.3' to corner 2
- C - Mag nail set in W. side wood post, 1' a.g., 22.5' to corner 1, 18.1' to corner 2
- D - Boone County witness mark, flush, 15.7' to corner 1, 25.3' to corner 2
- E - Boone County witness mark, flush, 13.1' to corner 1, 22.5' to corner 2

Boone County witness mark is a 3/8" diameter x 2' long rebar bearing a metal cap stamped "Boone County Witness Point."

See page 2 for written documentation and explanation of findings.

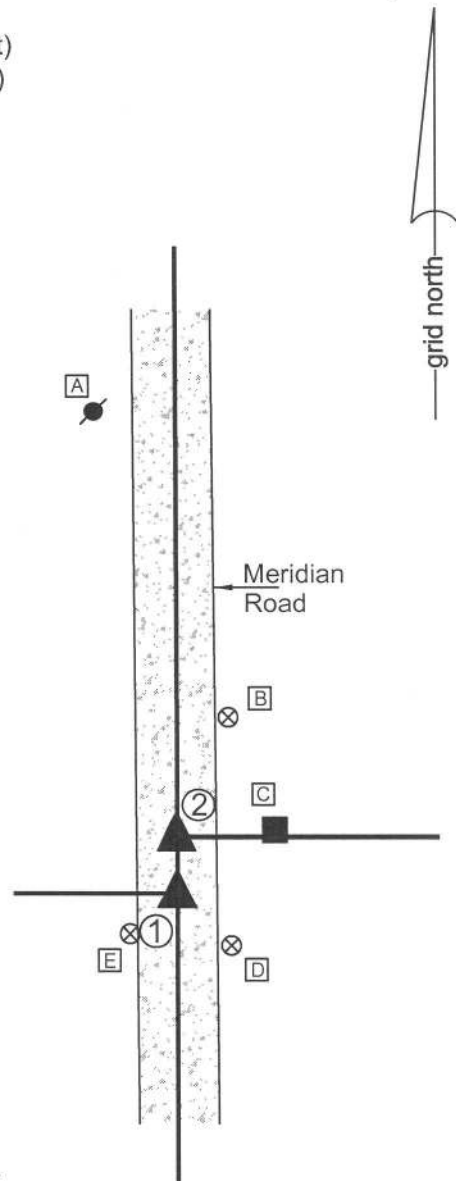

Kenneth E. Hedge
Kenneth E. Hedge, County Surveyor

James S. Swift
James S. Swift, IN LS 20200054

March 27, 2015, page 1 of 2

Sugar Creek Township	Washington Township
Section 13 T20N, R1W	Section 18 T20N, R1E
Section 24 T20N, R1W	Section 19 T20N, R1E

SECTION CORNER RECORD

NW 900-000

BOONE COUNTY SURVEYOR'S OFFICE

The Harrison monument at corner two (SW Sec. 18, NW Sec. 19, T20N, R1E) was set over a stone found and the Harrison monument at corner one (SE Sec. 13, NE Sec. 24, T20N, R1W) was set in place of a portion of an ancient wood post / wood stake found.

Corner one was set in 1819, an original corner defining the Second Principal Meridian. Corner two was set in 1819, 19 links north of corner one. Two matching records in the BCS Surveyor's record dated February 25, 1879 address this set of corners. With respect to the southeast corner of Section 13, T 20 N, R 1 W (corner one), the record states "Marked rock to place at corner to Sec. 18 & 19, 19 lks North." With respect to the southwest corner of Section 18, T 20 N, R 1 E (corner two), the record states "Found point which marked by chopping notch in crosslaying also marked (+) rock 16.9.6 for parties to set." A BCS tie card dated July 23, 1975 and referencing the southwest corner of section 18 states "No stone found - set rod" and shows the corner in the center of the N-S roadway in line with a fence to the east.

This corner was excavated on July 9, 2014. Corner two was excavated first. Prior to excavation, an iron rod was found 2 inches deep in the gravel road, bent at the top and in line with a post and occupation line to the east. The iron rod was removed and found to be smooth shafted and 18 inches long. The position of the rod fit with the 1975 tie to the post on the east side of the road. Excavation revealed a thin piece of wood, 12 inches long by 5 inches wide found at 18 inches deep in the general vicinity of the rod. Further excavation revealed a stone found at 2 feet deep, south and west of the rebar. The stone was vertical and matched the dimensions described in the 1879 record, being 16 inches tall by 6 inches by 9 inches. The stone was not oriented in cardinal directions, as would be expected if had been set by the County Surveyor. However, the record states that the stone was marked "for parties to set" which indicates that the land owners were responsible for actually placing the stone in the ground. The top of the stone was oriented in a NE/SW orientation but it was noted that the stone had a distinctly flat and vertical side facing east. Given that this is the corner to sections 18 and 19, defining the line to the east, it is logical that the land owners would orient the stone in such a manner. Two other features of the stone were notable: a wood stake was found at the northeast edge of the stone and the stone itself appeared to be set deeper in the ground than would be expected, given the general lay of the land. Both of these features are discussed below.

After the stone was found, a probable location for corner one was determined and excavation was performed at this location. Here, a piece of wood was found at 20 inches deep. This piece of wood appeared to be a fragment of an old post being squared off on the sides and approximately 4 inches by 3 inches by at least 4 feet long. The piece of wood was found embedded in the clay layer below the road and lying perpendicular to the north-south road. An 18 inch fragment of the post was removed from the road, measured and analyzed. The remainder of the post was left in the ground as found. The full length of the post was not determined and it appeared to extend yet further east and west than that portion which was exposed. Careful analysis of the post indicates that in the approximate center of the fragment which was removed, hence directly south of the stone, a vague notch is visible. The notch is not deep and was not observed at the time the post was found. However, after the post dried in the open air and the surface of the post cracked slightly, the notched part of the post became apparent. One edge of the notch bears distinct evidence of having been chiseled. The center of the post was found at 11.8 feet south of the top, center of the stone. The record closing distance is 19 links, or 12.54 feet. This distance is also stated in the 1879 records. It is noted that while the distance between the post and stone was found to be less than the record distance, the distance measured between post and the fragments of the wood stake at the northeast edge of the stone at corner two was very close to the record distance.

Analysis of the record and the found evidence yields the following conclusions. It is believed that the wood post found under the road and discussed above represents the monument referred to as the "crosslaying" in the 1879 record. The object was found lying perpendicular to the meridian line, or 'crosslaying' the meridian line, with a notch evidently chopped into it. The notations in the BCS Surveyor's Record indicate that this 'crosslaying' was found at the closing corner (corner two), not the standard corner (corner one.) It is believed that the crosslaying is misreferenced to the wrong section. Notably, it can be proven that the record immediately below the reference to the crosslaying, made on the same date, refers to an object in the wrong section. Hence, it appears the record keeping was problematic on that day with respect to which corner was which and what section was what. This is not particularly surprising, given that there are two corners, 12 feet apart, which represent the corners for four different sections in two different ranges, east and west of the 2nd Principal Meridian. With respect to the stone found at the closing corner, several observations are noted: The record clearly indicates that the stone was marked by the County Surveyor but not set by him. The stone was found oriented in a different manner than is typical of corner stones set by the County Surveyor but in a manner which makes sense given that the landowners who set the stone were marking the line to the east, as noted above. A wood stake was found at the northeast corner of the stone. The stone is slightly closer to the 'crosslaying' than the record 19 links, but the wood stake was quite close to that record distance from the 'crosslaying.' It is the opinion of the undersigned that the most probable occurrence on February 25, 1879 was that the County Surveyor or his crew found the post which they referred to as the 'crosslaying' defining the north-south position of the standard corner, chopped a mark in it to define the east-west position of that corner and set a wood stake to mark the position of the closing corner. At some subsequent date, the interested 'parties' set the stone next to the wood stake, leaving the stake in place, and setting the stone in a manner inconsistent with that typically adhered to by the County Surveyor. If this is true, it would hold, then, that the stake marks the true position of corner two and that the stone is slightly south and west of the corner. However, given the inherent conjecture of the above statement and the presence of the apparently undisturbed stone, the stone was held as marking the closing corner. The standard corner was set at the north-south position of the found 'crosslaying' on the prolongation of a line connecting the stone with the standard corner approximately one half mile to the north, where the meridian line crosses the county boundary. Hence, the meridian line bends at the standard corner, as per the original federal procedures, and the distance between the two monuments is slightly less than the record closing of 19 links. As the notch on the crosslaying was not observed during the original fieldwork, it is not possible to state whether the Harrison monument at the standard corner is in the exact position of the notch. In light of the above conclusions, it is thought to be most likely that the Harrison monument is slightly west of the position of the notch on the crosslaying.

Two other features of this corner and the monumentation found are notable. Although the record clearly states that the stone was "marked (+)," no marks were found on the stone. Perhaps a mark was present but was sufficiently vague to prevent detection in the field on July 9, 2014. As stated above, the notch on the crosslaying post was not observed on that date but was subsequently observed upon more careful inspection and after changes in the character of the surface of the wood. As the stone was left in place, buried under the road, with a substantial monument placed above it, further inspection was not practical. The dimensions of the stone precisely matched the 16.9.6 dimensions noted in the 1879 record.

The other feature of this corner which merits comment is with respect to the wood post, accepted as being the 'crosslaying.' This term has not been found mentioned elsewhere in the BCS Surveyor's Record, but as discussed above, fits well with the observation that the post was found laying perpendicular to and across the meridian line. The age of the post is not known, but apparently it was already present in 1879. As noted above, the post is 3 inches by 4 inches by at least 4 feet long. This is quite small for a fence post and rather large for a survey stake but is similar to the dimensions for a monument proscribed by Edward Tiffin's Instructions to the federal Deputy Surveyors, in force at these corners were originally established. It is possible that this post represents the original wood post set to mark this corner in 1819 during the original federal survey of the Second Principal Meridian and the ranges to the west. No further proof of this offered, but the conjecture is sufficiently interesting to merit mention.


Kenneth E. Hedge, County Surveyor


James S. Swift, IN LS 20200054 March 27, 2015, page 2 of 2

PHOTOGRAPHIC DOCUMENTATION

Date of photography: July 9, 2014

View prior to excavation, looking across the corners and south along Meridian Road.



View prior to excavation, looking north along Meridian Road from above the closing corner.



The stone found at the closing corner. The chaining pin is stuck in the fragments of wood stake found at the northeast corner of the stone.



View from above the stone at the closing corner looking east along the field division line.



View of the stone found at the closing corner from above and northeast.



View of the stone found at the closing corner from above and eastnortheast. Note the flat, vertical face of the east side of the stone.



For details and documentation, refer to related sheet "Section Corner Record."

PHOTOGRAPHIC DOCUMENTATION

Date of photography: July 9, 2014

The stone found at the closing corner from above and west.



The eastern portion of the "crosslaying" as found situated perpendicular to the meridian line at the standard corner.



The east and west portions of the "crosslaying." The western portion had been removed and placed back in approximately the original position.



View from the north, looking across the stone at corner 2 and the area of excavation at corner 1.



The west portion of the "crosslaying." Note that the clay in which this piece of wood had been embedded 'popped' off the wood upon excavation, leaving the wood looking remarkably clean, given that it was embedded in clay as originally found moments earlier.



For details and documentation, refer to related sheet "Section Corner Record."

SECTION CORNER RECORD

NW 900-050

BOONE COUNTY SURVEYOR'S OFFICE

State Plane grid coordinates NAD83 (2011):

North: 1793172.21 East: 3122130.09 (U.S. survey feet)

Type of monument: Harrison, 4" disk 'Section Corner'



Depth: Two inches above adjacent ground

Indiana tie card references:

IN02_T20NR1W13_76 IN02_T20NR1W24_04


CORNER WITNESS DETAIL

SCALE 1" = 40'

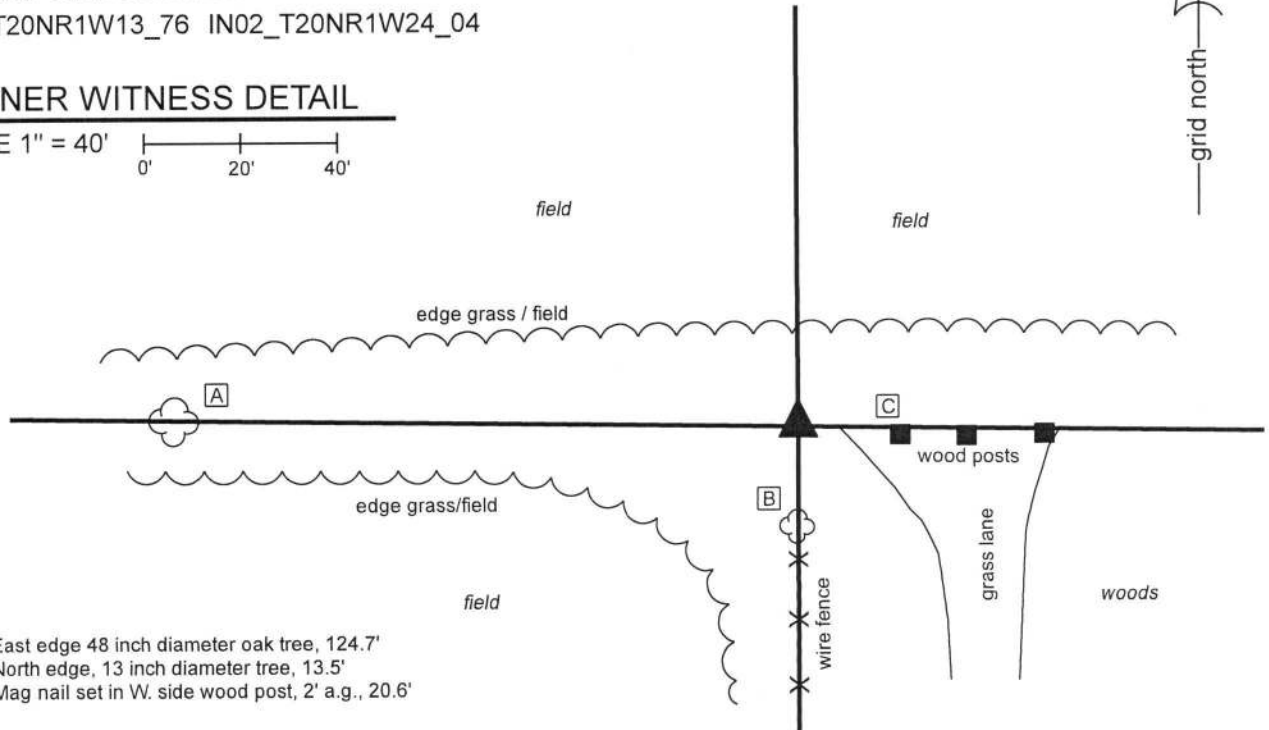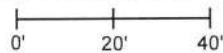

- A - East edge 48 inch diameter oak tree, 124.7'
- B - North edge, 13 inch diameter tree, 13.5'
- C - Mag nail set in W. side wood post, 2' a.g., 20.6'

The Harrison monument was set over the remains of an 8x6 inch cedar wood post. No specific descriptions of this corner were found in the BCS Surveyor's Record beyond the original establishment of the corner as a wood post in 1822, nor were any recent BCS tie cards found referencing the corner. A survey by Ronald E. Wharry, LS S0420, recorded as Instrument 201600007222 in the Office of the Boone County Recorder, shows the corner as a wood headpost. This corner was excavated on March 19, 2019. On that date, the headpost called in the Wharry survey was not visible above ground. It appears that the above-ground portion of the post had been removed. The remains of the base of the post were found at 11 inches below the surrounding ground, in-line with standing fencing slightly to the south and approximately in-line with several small, new wood posts to the east. The position of the base of the post fit with the position shown on the Wharry survey. Excavation around the base of the post revealed numerous rocks found, none of which matched the characteristics of a stone purposely set to mark the corner. As is typical with the remains of an old cedar headpost, the base of the post was in good condition below the ground. The base of the post is 8 inches E-W by 6 inches N-S. At 14 inches deep, a horizontal brace, also of cedar wood, was found along the south edge of the post, extending east and west from the post. The descriptions created by the Wharry survey call for the specific position of the quarter section corner to be the northeast corner of the post. However, no evidence was found which indicates that the northeast corner of the post is of more significance than other corners of the post. The brace was found along the south edge of the post. For purposes of monumenting the corner, the center of the post was held, consistent with the practice of this office at other corners where a corner post has been held as marking the section or quarter section corner. The remains of the post were left in the ground. Three two-foot sections of 1/2 inch diameter rebar were driven at angles around the edges of the post and a Harrison monument was anchored to the post and rebars and positioned directly above the center of the post.

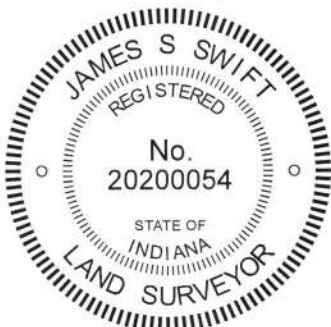

Kenneth E. Hedge
Kenneth E. Hedge, County Surveyor

James S. Swift
James S. Swift, IN LS 20200054

April 3, 2019

Washington Township

Section 13
T20N, R1W

Section 24
T20N, R1W

SECTION CORNER RECORD

NW 900-100

BOONE COUNTY SURVEYOR'S OFFICE

State Plane grid coordinates NAD83 (2011):

North: 1793207.88 East: 3119523.27 (U.S. survey feet)

Type of monument: Harrison, 4" disk 'Section Corner'

Depth: One inch below adjacent ground

Indiana tie card references:

IN02_T20NR1W14_80 IN02_T20NR1W13_72

IN02_T20NR1W23_08 IN02_T20NR1W24_00





CORNER WITNESS DETAIL

SCALE 1" = 50'

- A - Mag nail set in E. side wood end post, 0.5' a.g., 10.6'
- B - Mag nail set in N.W. side wood post, 0.5' a.g., 6.6'
- C - Mag nail set in S. side wood post, 0.5' a.g., 13.7'

The Harrison Monument was set in place of a 5/8 inch diameter rebar with a red plastic cap stamped "WIT POINT."
No specific descriptions of the corner were found in the old BCS Surveyor's Record. A BCS tie card dated April 23, 1974 calls the corner as a stone found with Chiseled "+".
The found rebar fit precisely with the one remaining tie from the 1974 tie card and also fit graphically with the representation of the corner as being between the right-of-way of State Road 39 and the end post of a fence to the west, in line with the fence. Manual excavation around the rebar and probing in the immediate vicinity of the rebar did not yield further evidence of the corner. Excavation around the rebar clearly demonstrated that the top 8 inches of the soil have been disturbed in recently with various rocks and gravel found mixed with pieces of plastic and rubber. The clay layer was below the soil layer was found at 15 inches. The stone called in the 1974 record was not found. The position of the rebar matches the tie card and the rebar is known to have been held as the corner on numerous private surveys. It is believed that the rebar replaced the stone in the same position.
The rebar was held as marking the corner and was replaced with a Harrison Monument on September 13, 2017.
This corner was originally established as a wood post in 1822.

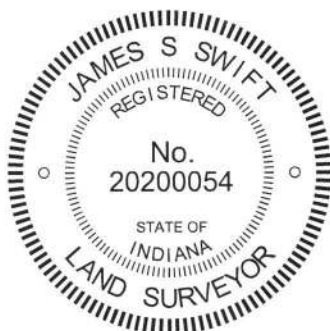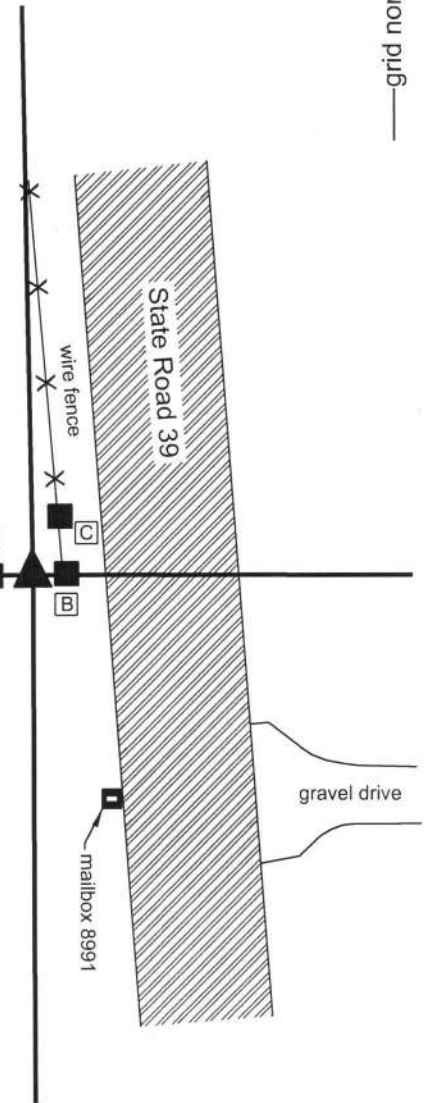

Kenneth E. Hedge
Kenneth E. Hedge, County Surveyor

James S. Swift
James S. Swift, IN LS 20200054
September 19, 2017

Washington Township

Section 14 T20N, R1W	Section 13 T20N, R1W
Section 23 T20N, R1W	Section 24 T20N, R1W

SECTION CORNER RECORD

NW 950-000

BOONE COUNTY SURVEYOR'S OFFICE

State Plane grid coordinates NAD83 (CORS96):

Corner 1: North: 1795779.03 East: 3124750.12 (U.S. survey feet)

Corner 2: North: 1795781.99 East: 3124750.08 (U.S. survey feet)

Type of monument: Harrison, 4" disk 'Section Corner'

Depth: two inches below adjacent road surface

Indiana tie card references:

IN02_T20NR1E18_36

IN02_T20NR1W13_44


CORNER WITNESS DETAIL

SCALE 1" = 40'



- A - Mag nail set in E. side power pole, 2' a.g., 58.1' to corner 1, 57.1' to corner 2
- B - Mag nail set in S. side power pole, 2' a.g., 60.7' to corner 1, 57.9' to corner 2
- C - Boone County witness mark, flush, 35.2' to corner 1, 32.5' to corner 2
- D - Boone County witness mark, flush, 23.1' to corner 1, 25.4' to corner 2

Boone County witness mark is a 3/8" diameter x 2' long rebar bearing a metal cap stamped "Boone County Witness Point."

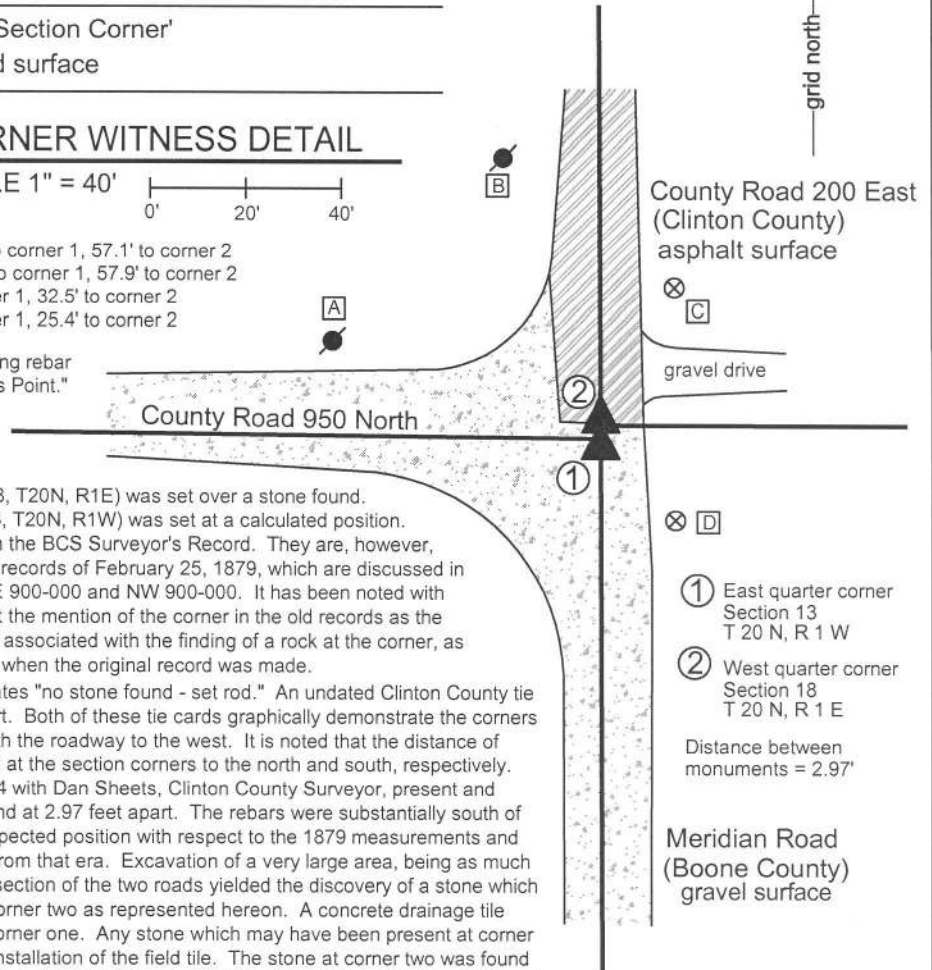


The Harrison monument at corner two (W. 1/4, Sec. 18, T20N, R1E) was set over a stone found. The Harrison monument at corner one (E. 1/4, Sec. 13, T20N, R1W) was set at a calculated position. No specific descriptions of these corners were found in the BCS Surveyor's Record. They are, however, mentioned as terminal points for measurements in the records of February 25, 1879, which are discussed in length on the documentation sheets for the corners NE 900-000 and NW 900-000. It has been noted with respect to other corners throughout Boone County that the mention of the corner in the old records as the terminal point for lines and measurements is generally associated with the finding of a rock at the corner, as some object had been present from which to measure when the original record was made.

A BCS tie card for corner two, dated July 23, 1975, states "no stone found - set rod." An undated Clinton County tie card states "bar" and shows the corners 2.97 feet apart. Both of these tie cards graphically demonstrate the corners to be at the intersection of the north-south roadway with the roadway to the west. It is noted that the distance of 2.97 feet is the average of the closing offsets recorded at the section corners to the north and south, respectively. These corners were excavated on September 11, 2014 with Dan Sheets, Clinton County Surveyor, present and participating. Prior to excavation, two rebars were found at 2.97 feet apart. The rebars were substantially south of the roadway to the west and were also south of the expected position with respect to the 1879 measurements and the scale factors which are applied to measurements from that era. Excavation of a very large area, being as much as 17 feet north-south by 6 feet east-west, at the intersection of the two roads yielded the discovery of a stone which was determined to be marking the closing corner, or corner two as represented hereon. A concrete drainage tile was found crossing under the road at the position of corner one. Any stone which may have been present at corner one in the past would have been removed during the installation of the field tile. The stone at corner two was found at 16 inches deep. With 14 inches of the top of the stone exposed, it measured 16 inches N-S by 7 inches E-W and did not appear to be much taller than that part which was exposed. The east side of the stone was flat and vertical. The stone was embedded in the clay layer below the road, protruding approximately 3 inches into the bottom of the road bed. After the stone and tile were found, excavation was performed to at least 5 feet north of the stone to determine if any further evidence would indicate that this stone actually represented the position of corner one, not corner two. No further evidence was found to the north. With respect to the evidence of the physical roadway to the east, the record and measured distances to the section corner to the south and the presence of the concrete tile representing a positive reason why corner two might not be present, the found stone was accepted as marking corner two. A Harrison monument was set over the top, center of the stone. The position of corner one was calculated to be at 2.97 feet south of corner two along a prolongation of the range line as determined by the stone at corner two and a railroad spike found at the apparent northeast corner of Section 13, T20N, R1W in Clinton County. A Harrison monument was set at this calculated position. Corner one was established in 1819. Corner two was not set by the original federal surveyors and is not an original corner.

- ⊗ D
- ① East quarter corner Section 13 T 20 N, R 1 W
- ② West quarter corner Section 18 T 20 N, R 1 E
- Distance between monuments = 2.97'


Meridian Road (Boone County) gravel surface

Jackson Township Clinton County

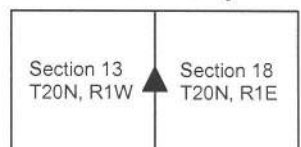

Washington Twp Boone County

Clinton Township Boone County

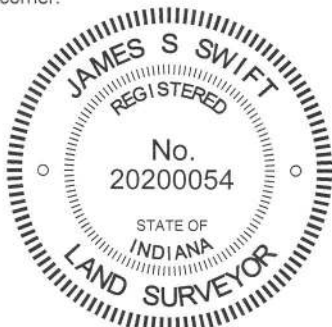

Kenneth E. Hedge
 Kenneth E. Hedge, County Surveyor

James S. Swift
 James S. Swift, IN LS 20200054

March 27, 2015

PHOTOGRAPHIC DOCUMENTATION

Date of photography: September 11, 2014

The stone at corner 2 or originally found.




The stone at corner 2 more fully exposed.



Remnants of a clay tile found crossing the position held for corner 1. See attached report.



View from the south, looking across the stone and north along the Clinton County Road 200 East. The trench crossing the excavation area at an angle contained the remnants of the clay tile.

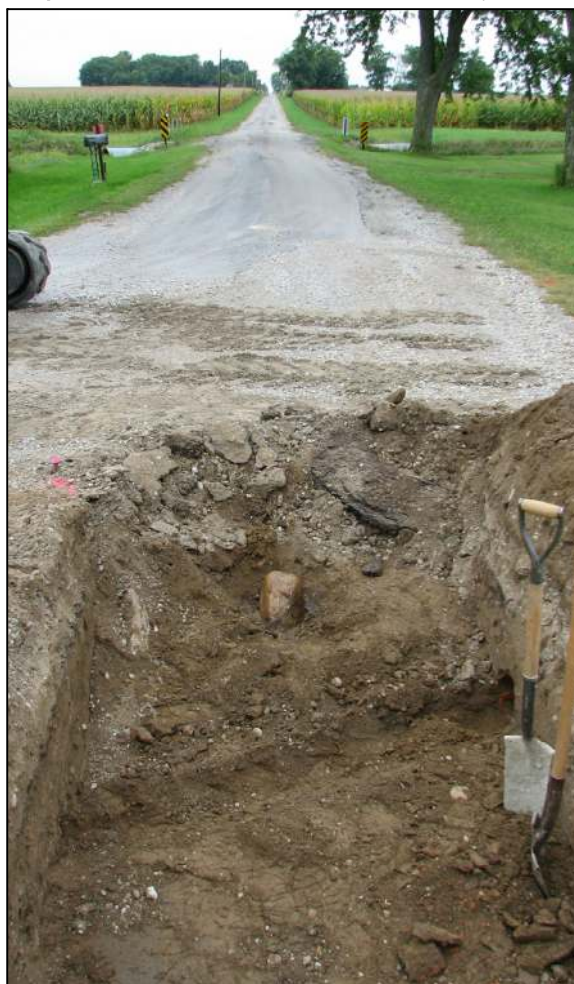

View from the south, showing the stone and the excavation area partially reconstructed.



For details and documentation, refer to related sheet "Section Corner Record."

SECTION CORNER RECORD

NW 950-050

BOONE COUNTY SURVEYOR'S OFFICE

State Plane grid coordinates NAD83 (CORS96):

North: 1795810.03 East: 3122118.46 (U.S. survey feet)

Type of monument: Harrison, 4" disk 'Section Corner'


Depth: six inches below adjacent gravel road surface

Indiana tie card references:

IN02_T20NR1W13_40


CORNER WITNESS DETAIL

SCALE 1" = 30'

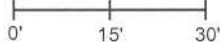

- A - Boone County witness mark, flush, 36.0'
- B - South face, octagonal concrete post, 2' a.g., 16.2'
- C - Boone County witness mark, flush, 13.6'


Boone County witness mark is a 3/8" diameter x 2' long rebar bearing a metal cap stamped "Boone County Witness Point."

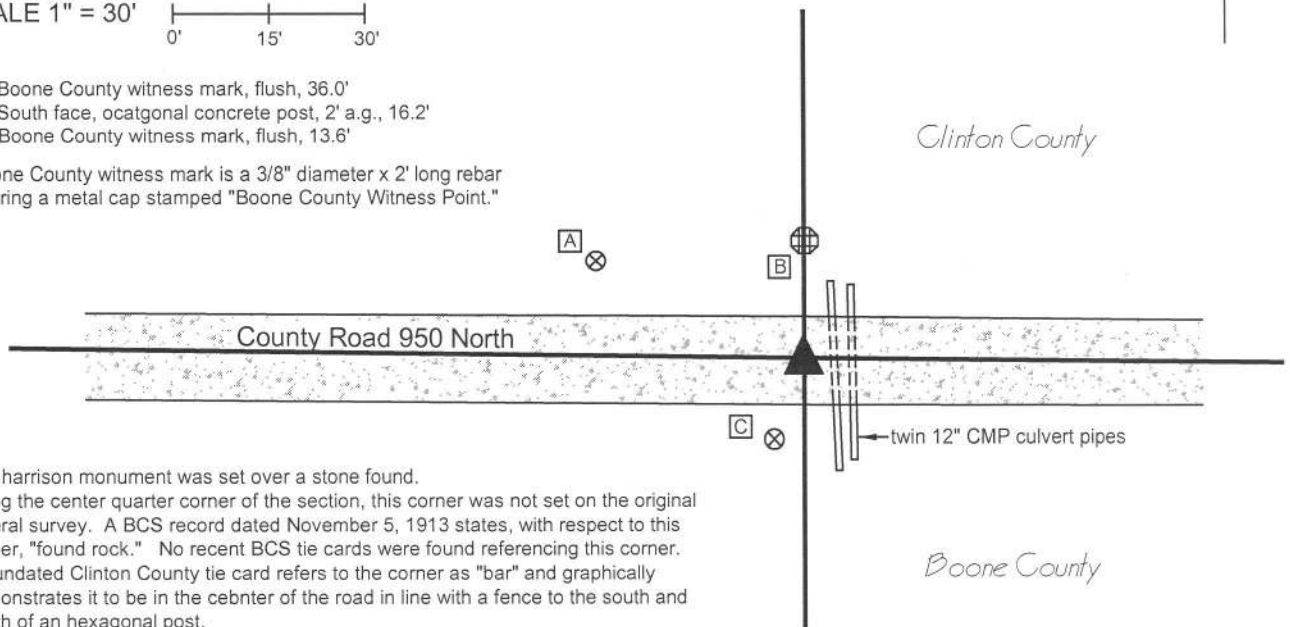


The harrison monument was set over a stone found. Being the center quarter corner of the section, this corner was not set on the original federal survey. A BCS record dated November 5, 1913 states, with respect to this corner, "found rock." No recent BCS tie cards were found referencing this corner. An undated Clinton County tie card refers to the corner as "bar" and graphically demonstrates it to be in the center of the road in line with a fence to the south and south of an hexagonal post.

This corner was excavated on September 8, 2015. Prior to excavation, an iron rod was found at 4 inches deep in the roadway. The position of the rebar fit with the one remaining distance tie shown on the undated Clinton County tie card. The iron rod was removed and determined to be a smooth shafted rod, 5/8 inch diameter, 34 inches long. Further excavation revealed a stone found at 13 inches deep, slightly north of the rebar. The stone was embedded in the clay layer below the road, protruding approximately 2 inches into the bottom of the road bed. The stone appeared to be vertical but was not oriented in cardinal directions, being in more of a NE-SW orientation. With the top 9 inches of stone exposed, it measured 8 inches NE-SW by 6 inches SE-NW and remained entirely stable in the clay, clearly being much larger in the vertical dimension. No specific marking were found on the stone though a distinct high point was visible. The stone was accepted as the best available evidence of the corner and was held as marking the corner. A Harrison monument was set over the top, high point. The iron rod, removed during excavation, had been 0.3 foot west and 1.5 feet south of the top, high point of the stone.


 Kenneth E. Hedge, County Surveyor


 James S. Swift, IN LS 20200054
 March 27, 2015

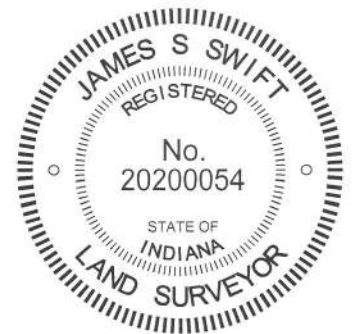

PHOTOGRAPHIC DOCUMENTATION
Date of photography: September 8, 2014

The stone as originally found.



The stone more fully exposed.



View of the stone and the large concrete post on the north side of the road.



View from the west, looking across the stone and east along County Road 950 North.



For details and documentation, refer to related sheet "Section Corner Record."

SECTION CORNER RECORD

NW 950-100

BOONE COUNTY SURVEYOR'S OFFICE

State Plane grid coordinates NAD83 (CORS96):

North: 1795843.34 East: 3119477.99 (U.S. survey feet)

Type of monument: Harrison, 4" disk 'Section Corner'

Depth: six inches below adjacent gravel road surface

Indiana tie card references:

IN02_T20NR1W14_44 IN02_T20NR1W13_36




CORNER WITNESS DETAIL

SCALE 1" = 40'

- A - South face, concrete R/W monument, 17.4'
- B - Mag nail set in S. side power pole, 2' a.g., 17.2'
- C - Boone County witness mark, flush, 26.5'
- D - N. edge, concrete R/W monument, 17.8'


Boone County witness mark is a 3/8" diameter x 2' long rebar bearing a metal cap stamped "Boone County Witness Point."

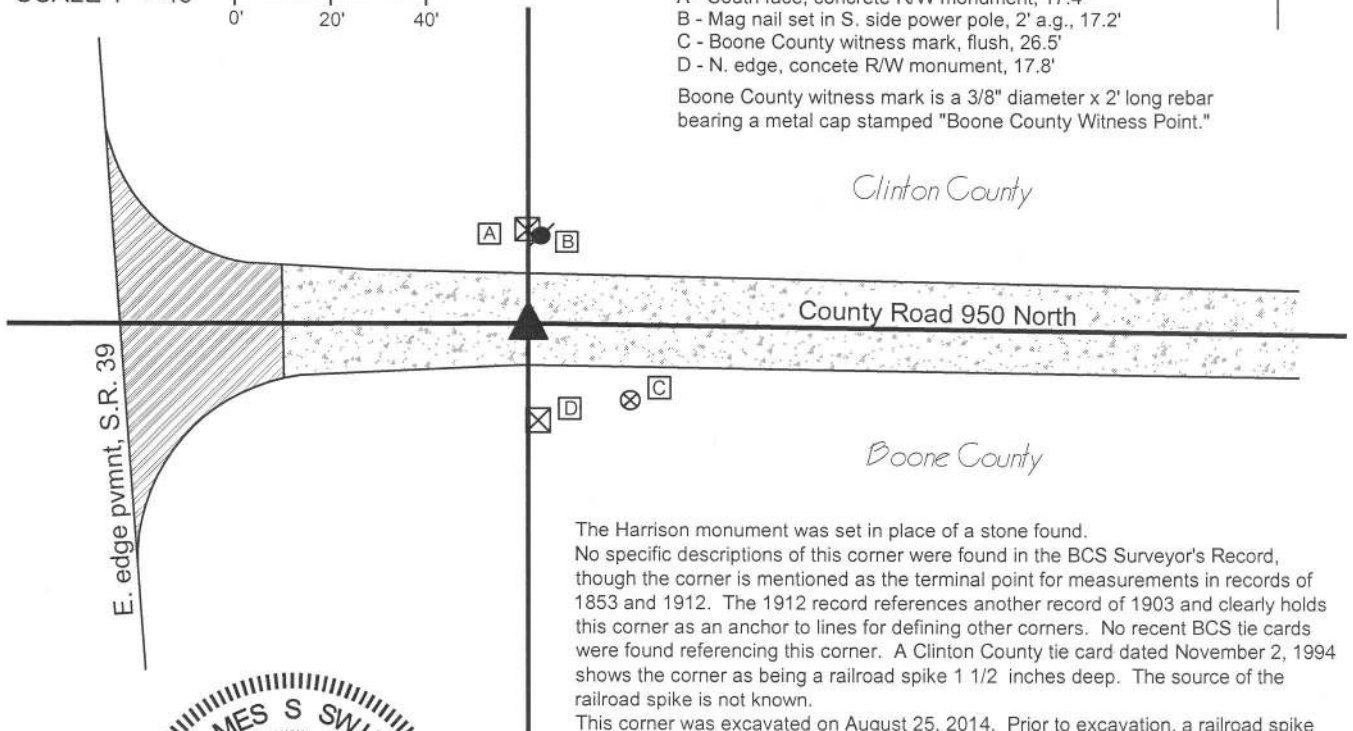

The Harrison monument was set in place of a stone found. No specific descriptions of this corner were found in the BCS Surveyor's Record, though the corner is mentioned as the terminal point for measurements in records of 1853 and 1912. The 1912 record references another record of 1903 and clearly holds this corner as an anchor to lines for defining other corners. No recent BCS tie cards were found referencing this corner. A Clinton County tie card dated November 2, 1994 shows the corner as being a railroad spike 1 1/2 inches deep. The source of the railroad spike is not known.

This corner was excavated on August 25, 2014. Prior to excavation, a railroad spike was found at 4 inches deep in agreement with the distance ties shown on the Clinton County tie card. Excavation revealed a stone found at 12 inches deep west of the railroad spike. The stone was 7 inches tall, 5 inches E-W by 4 inches N-S. It was vertical and embedded in the clay layer below the road, protruding 2 inches out of the clay into the bottom of the road bed. The stone is smaller than most stones found marking corners throughout the county but otherwise matched the characteristics of a corner stone, being vertical, embedded in the clay layer below the road and oriented in cardinal directions. The stone also had a distinct high point. Excavation of a large area around the stone revealed no further evidence of the corner. The stone was accepted as the best available evidence of the corner and held as marking the corner. The stone was removed and a Harrison monument was set in place of the stone at the horizontal position of the top, high point of the rock. The railroad spike, removed during excavation, had been 0.9 foot east and 0.15 foot south of the top, high point of the stone.

This corner was originally established as a wood post in 1822.

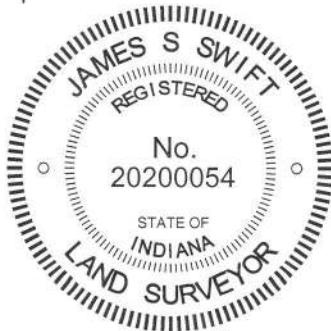

Kenneth E. Hedge, County Surveyor

James S. Swift, IN LS 20200054
 March 27, 2015

Jackson Township
 Clinton County
 Washington Twp
 Boone County

Section 14 T20N, R1W	Section 13 T20N, R1W
-------------------------	-------------------------

PHOTOGRAPHIC DOCUMENTATION

Date of photography: August 25, 2014

The stone as originally found.



The stone, exposed. Viewed from the east.



Excavation below the stone, showing the cross section of the roadway. Note the distinct clay layer in which the stone was embedded.



For details and documentation, refer to related sheet "Section Corner Record."

View from the east, looking across the stone, across State Road 39 and west along the County Line Road (Boone C.R. 950 North)

