


spike was set in place of the top, center of the railroad rail to mark the corner pending further investigation. It is noted that the origin of the railroad rail is spike was set in place of the top, center of the railroad rail to mark the corner pending further investigation. It is noted that the origin of the railroad rail is not known and that no BCS tie cards were found referencing the rail, but it is likely that it was set by representatives of this office between 1968 ad 1973. Deed research indicates that the properties to the west and southwest (see Instruments 200600012835 & 2018001010) are described from the Mag nail. No deed descriptions indicating evidence contrary to the mag nail and railroad rail was found and the rail was held as providing the best available evidence of the corner. A 5/8 inch rebar was found witnessing the corner on the west side of the county road, in line with the nail/rail/spike. On June 6, 2019, a final position for Corner 1 was established on the range line as noted above, 0.9 foot east of the railroad spike which had been set in place of the rail in 2012. A Harrison monument was set at that position on that date. The railroad spike was removed and the Mag nail had been removed in 2012.

No. 20200054	Kenneth E. Hedge, County Surveyor	Union Twp Boone Cnty	Washington Twp Hamilton Cnty
	James S. Switt, IN LS 20200054 July 31, 2019	Section 36 T19N, R2E	Section 31 T19N, R3E

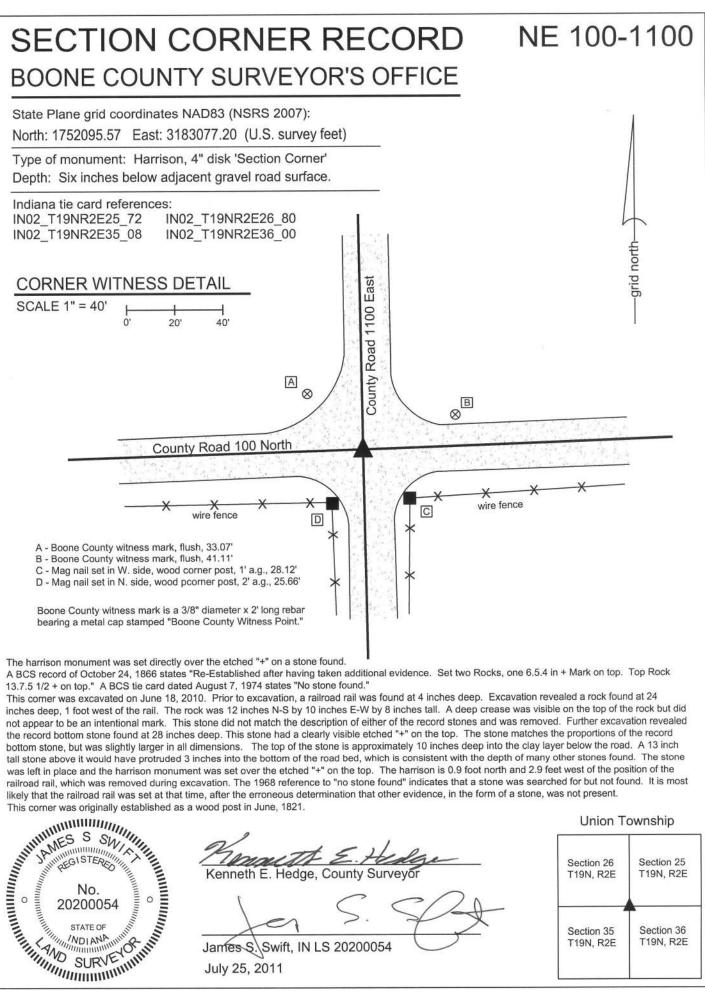

$\zeta <$	3/20
7	T
ft, IN LS 20200054	\smile

James S Sw July 25, 2011

Section 26	Section 25
T19N, R2E	T19N, R2E
Section 35	Section 36
T19N, R2E	T19N, R2E

BOONE COUNTY SURVEYOR'S OFFICE

NE 100-1100

PHOTOGRAPHIC DOCUMENTATION Date of photography: June 18, 2010


View of the stone from above.




Close-up of the stone.



For details and documentation, refer to related sheet "Section Corner Record."

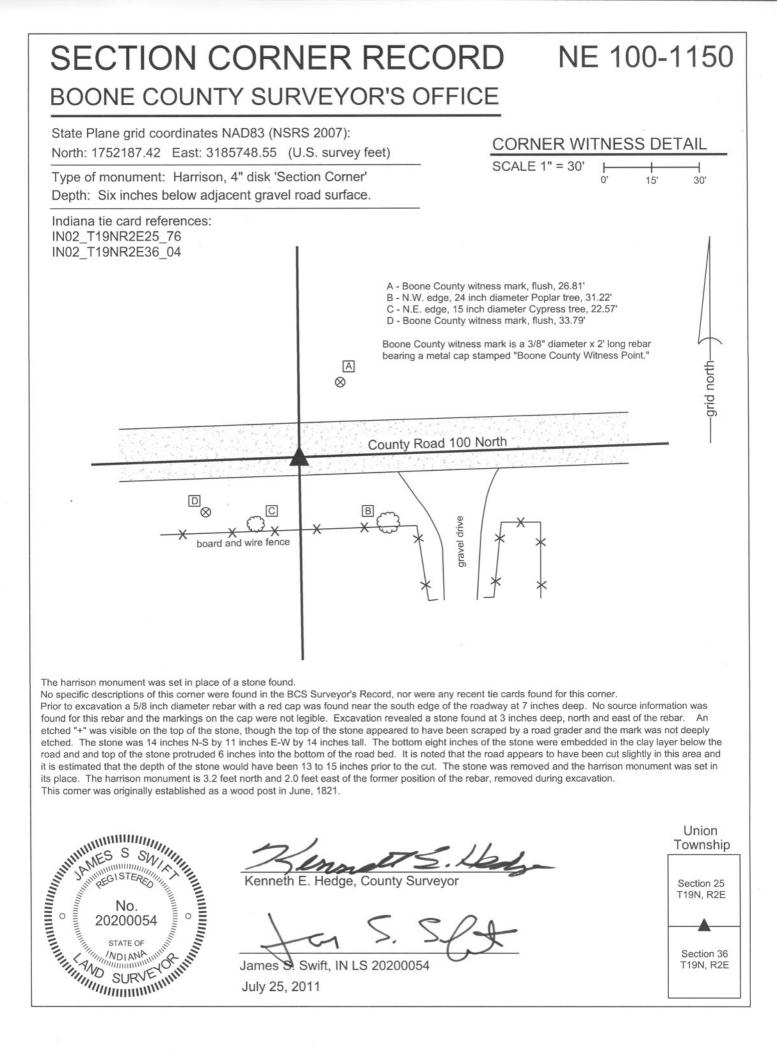

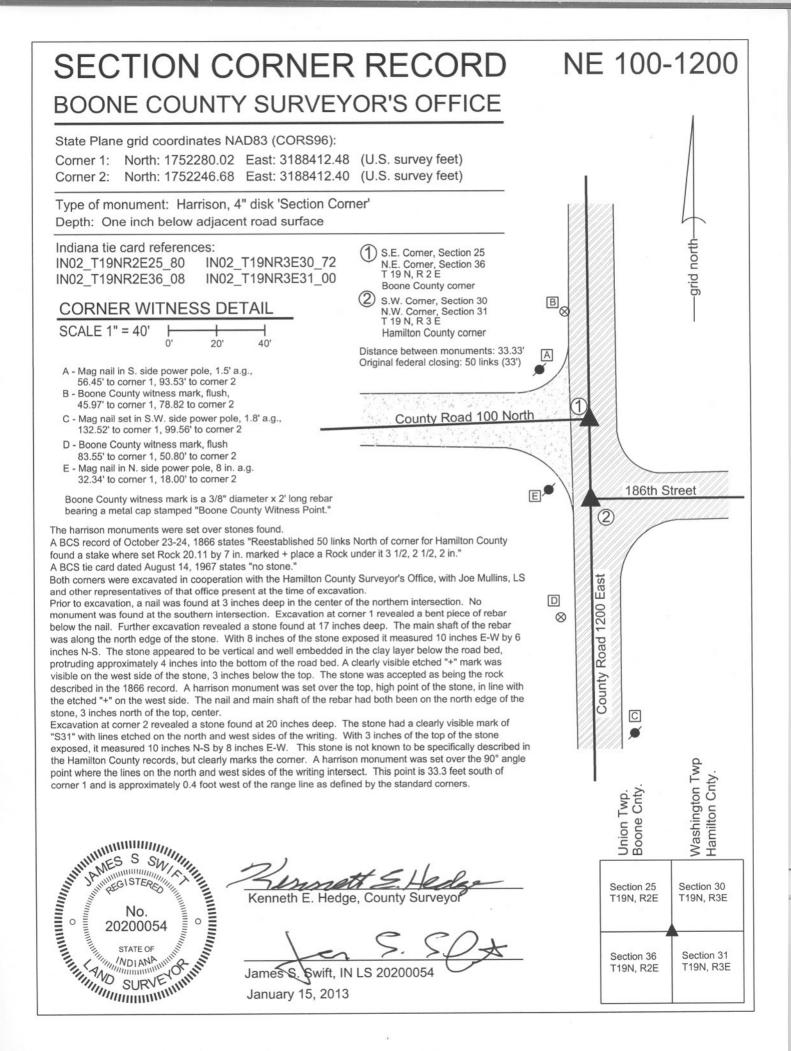

BOONE COUNTY SURVEYOR'S OFFICE

NE 100-1200

PHOTOGRAPHIC DOCUMENTATION Date of photography: July 17, 2012

View of the stone at the Boone County corner (corner 1) and the adjacent rebar from the north.



View of the stone at corner 1 from the north, looking south across the Hamilton County corner and along the County Line Road.



For details and documentation, refer to related sheet "Section Corner Record."

View of the stone at corner 1 from above and from the west.



The stone at the Hamilton County corner (corner 2) as found.



The stone at corner 2 with paint.

